


Section 35 Township 34 Range 2E

Well No. #2 Buffington

Company Harold Martin
~~Martin & Cash~~

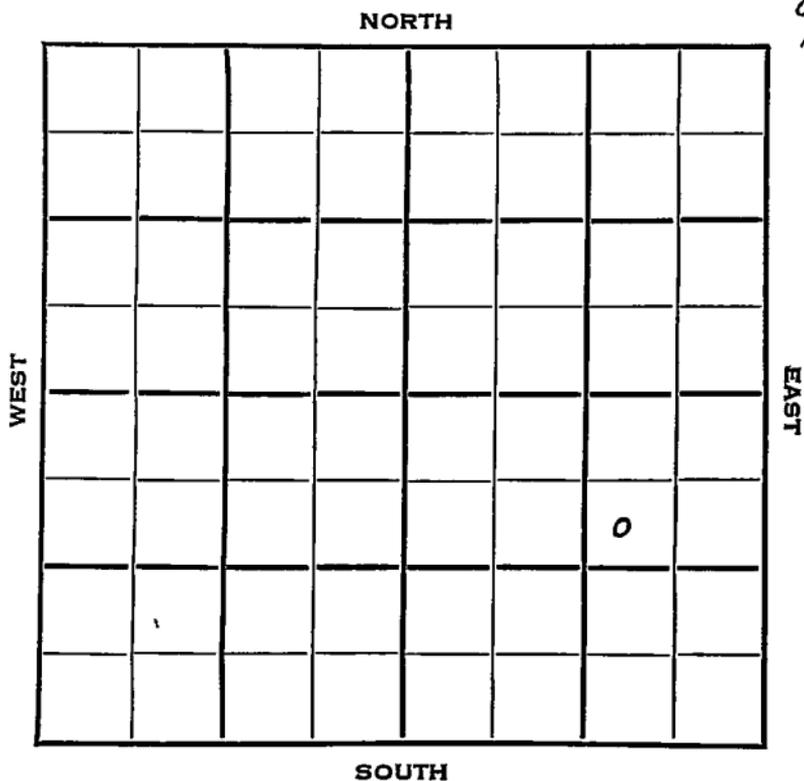

O. W. D. D

Sumner

KANSAS

SEC. 35	TWP. 34	R. 2E	✓
------------	------------	----------	---

WELL NO.

#2 Buffington FARM


COMPANY

~~Harold Martin
Martin & Cash~~

CONTRACTOR

~~Smitherman
Martin & Cash~~990 Hill Top Pool
~~990~~ Ft. from N. Line~~990~~ Ft. from S. Line990
~~990~~ Ft. from E. Line~~990~~ Ft. from W. Line

NORTH

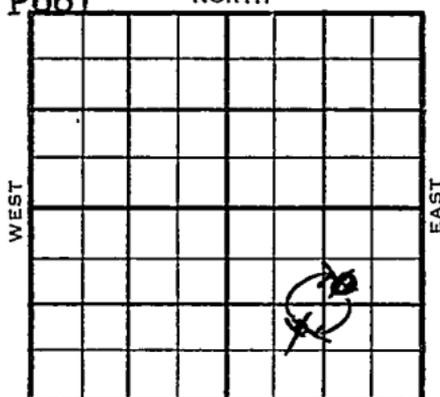

SW NE SE
~~NE SW SE~~
~~SW NE SE~~

ELEVATION

1222'

REPORT

1954

2/17

M I R

3/10

Spud 2-16-54
 SWD Well.
 TD 2556'
 10" @ 100'
 Stal. 2385'
 TD 2544'
 7" @ 2446'
 DD 2556'
 Comp SWD Well.

ABANDONED

1954

=

O. W. D. D

9/8

Spud 9-7-54 Stal 2368' OTD 2544'
 7" @ 2446' To DD to Bart.

10/20

Spud 9-7-54 Oil well TD 3515'
 Stal. 2368 OTD 2544 7" @ 2446
 Layton 2798 KC 2998 Oswego 3198
 Bart 3480 TD 3515 4 1/2" @ 3495
 P/64 BO 10 hr. Comp. 25 BOPD

COMPLETED

County **Sumner** State **Kansas**

Sec. **35** (Blk. Twp.) **34** (Sur. Rge.) **2E** Map No.

Operator **Martin & Cash**

Well No. **2** Farm **Buffington**

Elev. Location **SW NE SE**

990 Ft. From **N** Line **SE**

990 Ft. From **E** Line Quarter

1st. Report **FEB 17 1954**

Completion

Remarks **Martin & Cash - Contr.**

Spudding Date

Drlg. Data **Hill Top Pool**

M I R

Kansas

Map No. _____ Sec. 35 Twp. 34 R. 2E

Well No. 2 Buffington

Harold Martin Company

CORRECTION

Contractor

SW NE-SE---

O. W. D. D SECTION PLAT

990 *See back*
Ft. from N. Line

_____ Ft. from S. Line

990 Ft. from E. Line

_____ Ft. from W. Line

			0

Summer Co.

Location _____

Rig up _____

Drilling and Remarks:

Reported

~~NE SW SE~~

incorrect
(OVER)

RECORD

Cased _____ in., _____ ft.

Sand _____

Gas _____

Oil _____

Total Depth _____

PRODUCTION

1st 24 hrs. Nat. _____

1st 24 hrs. after shot _____

Gas _____ Cu. Ft.

Dry Hole _____

Abandoned _____

Date

SEP 15 1954

FABEN GILSTRAP

Scout

Mr. Gilstrap,

The Martin co., a few weeks ago,
drilled a #2 in the SW, NE, SE &
completed it D & A at 2556'.

Where do we go from here?

Please check....

Thanks-----

Luville

Luville:

Same well.

SW NE SE - OWDD

Faben

SEP 17 1954

Scout Cards	<u>10</u>
Land Small Map	
Land Wall Map	<u>3</u>
Tracings	
France Map	
Pierce Map	
Misc.	

O. W. D. D

County Sumner State Kansas

Sec. 35 (Blk. 34 (Sur. 2E Map No.)
 (Twp.) (Rge.)

Operator Harold Martin

Well No. 2 Farm Buffington

Elev. 1222 Location SW NE SE

COMPLETE

990 Ft. From N Line SE

990 Ft. From E Line Quarter

Ist. Report

Completion Oct 20 1954

Remarks (OWDD) W.D.D
Smitherman - Contr.

Spudding Date 9-7-54

Drlg. Data Oil well TD 3515

Stal. 2368 OTD 2544 7" @ 2446

Layton 2798 KC 2998 Oswego 3198

Bart. 3480 TD 3515 4 1/2" @ 3495

P/ 64 bo 10 hr. Comp. 25 bopd