

Section 35 Township 34 Range 2EWell No. 1 Buffington "B"Company Martin & Cash

NORTH

9

							0

SOUTH

WEST

EAST

Sumner

KANSAS

SEC.	TWP.	R.
35	34	2E

WELL NO.

#1 Buffington 2B"

FARM

COMPANY

Martin & Cash

CONTRACTOR

Martin & Cash

330

Ft. from N. Line


Ft. from S. Line

330

Ft. from E. Line

Ft. from W. Line

NE NE SE

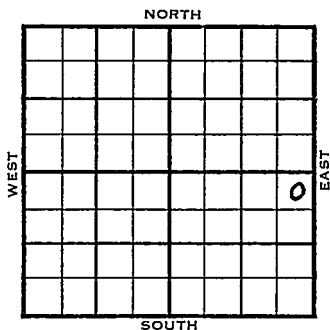

1953

ELEVATION

1225'

REPORT

11/11

R U R

12/2

Spud 11-10-53 Oil well TD 2814
 8" @ 107 Stal. 2385 Layton 2808
 TD 2814 5½" @ 2810 CO to 2814
 Comp. 20 BOPD

COMPLETED

J. G. McGEHEE

