


DX 78-1

Section 35 Township 34 Range 2E

Well No. 3 Buffington "B"

Company Martin & Cash

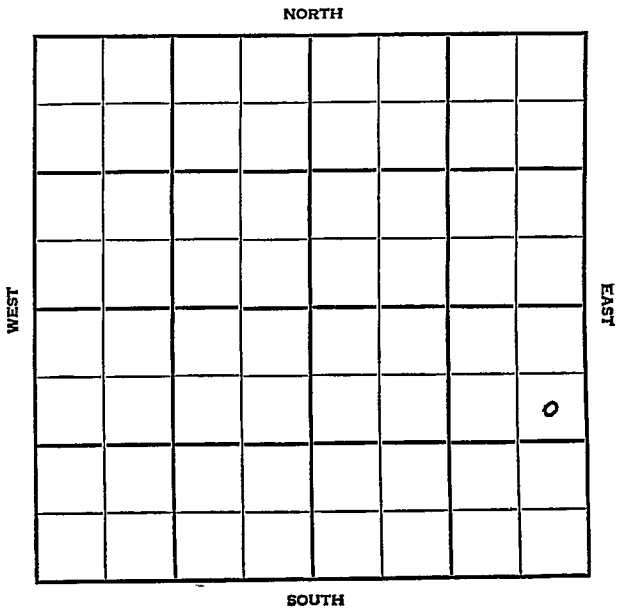

Sumner KANSAS


SEC.	TWP.	R.
35	34	2E

WELL NO. \_\_\_\_\_  
 COMPANY **3 Buffington "B"** FARM

CONTRACTOR **Martin & Cash**

**Martin & Cash**  
**q Hilltop Pool**

990 Ft. from N. Line  
 \_\_\_\_\_ Ft. from S. Line  
330 Ft. from E. Line  
 \_\_\_\_\_ Ft. from W. Line

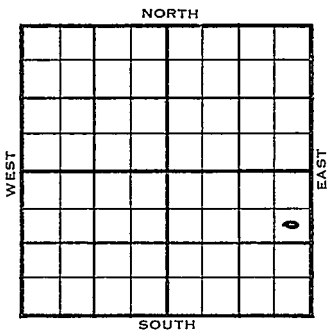

SE NE SE

	ELEVATION	REPORT
1954	1222	

6/9  
 8/4

RUR  
 Spdg 6-10-54  
 Oil well  
 TD 3515  
 8" @ 96  
 Stal 2361 Layton 2805 KC 3010  
 Bart. 3486  
 TD 3515  
 5" @ 3515 CO to 3515 24/ 3500-06  
 24/ 3506-12 Comp. 150 bopd

**COMPLETED**



