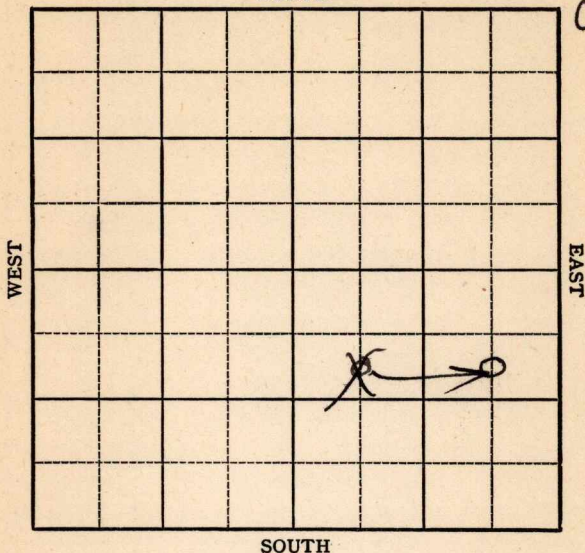


KANSAS

Saline

Section 10 Township 16 Range 3WWell No. 1 PhelanderCompany C E GouldOlson
NORTH

KANSAS Saline

Sec. 10 Twp. 16 R. 3W ✓

Well No. #1 Phelander Farm

C. E. Gould Company

Olson Pool

990' Ft. from N. Line


 Ft. from S. Line

660 Ft. from E. Line

~~660~~ Ft. from W. Line

CSL NE SE

~~CSL NW SE~~

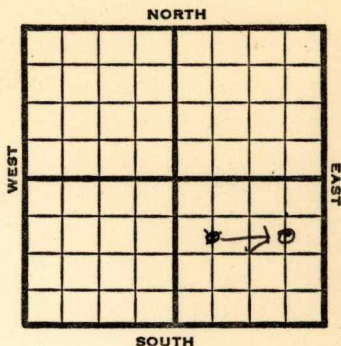

1949

Elev. 1312' REPORT

3/23

Location

3/30

"

4/6

"

4/12

"

4/20

"

4/27

"

5/4

"

5/10

"

5/18

"

5/25

140 fsg.

6/1

8" @ 315'

6/7

"

6/15

Miss 2842'

Drlg 3025'

6/22

Viola 3314'

TD 3390'

ABANDONED

Kansas


Map No. _____ Sec. 10 Twp. 16 R. 3WWell No. 1 PhelanderC. E. Gould CompanyFIRST REPORT Contractor

C S L NW SE

SECTION PLAT

990 Ft. from N. Line

_____ Ft. from S. Line

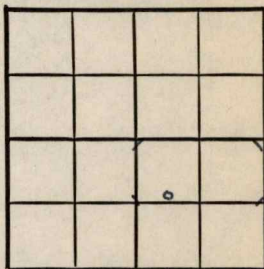000 Ft. from E. Line660 Ft. from W. LineSaline CountyLocation X

Rig up _____

Drilling and Remarks:

RECORD

Cased _____ in., _____ ft.

Sand _____

Gas _____

Oil _____

Total Depth _____

PRODUCTION

1st 24 hrs. Nat. _____

1st 24 hrs. after shot _____

Gas _____ Cu. Ft.

Dry Hole _____

Abandoned _____

Date

MAR 23 1949 19S. J. LEWIS


Scout

check feet measurement
+ advised

Sam

Don't use loc.

SECTION PLAT

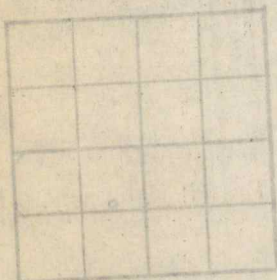

290 ft from N. line
ft from S. line
ft from E. line
ft from W. line

RECORD

ft. in. Cased Sand Gas

Location
Rise up
Drilling and Remarks

Scout Cards
Land Small Map
Land Wall Map
Tracings
France Map
Pierce Map
Misc.

[Handwritten signature]

Map No. 42 Sec. 10 Twp. 16 R. 3W

Well No. 1 Phelwander

C. E. Gould Company

CORRECTION

Contractor

C S L N E S E

SECTION PLAT

990 Ft. from N. Line

Ft. from S. Line

660 Ft. from E. Line

Ft. from W. Line

Saline County

Location

Rig up

Drilling and Remarks:

Reported

C S L N W S E

RECORD

Cased in., ft.

Sand

Gas

Oil

Total Depth

PRODUCTION

1st 24 hrs. Nat.

1st 24 hrs. after shot

Gas Cu. Ft.

Dry Hole

Abandoned

Date

APR 13 1949

19

S. J. LEWIS

Scout

Kansas

Map No. K42 Sec. 10 Twp. 16 R. 3WWell No. 1 PhelanderC. E. Gould

Company

ABANDONED

Contractor


C S L NE SE

21/312
SECTION PLAT990 Ft. from N. Line

Ft. from S. Line

660 Ft. from E. Line

Ft. from W. Line

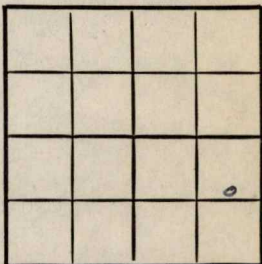

Saline County

RECORD

Location

Cased _____ in., _____ ft.

Rig up

Sand _____

Drilling and Remarks:

Gas _____

Oil _____

Total Depth 3390

PRODUCTION

1st 24 hrs. Nat. _____

1st 24 hrs. after shot _____

Gas _____ Cu. Ft.

Dry Hole _____

Abandoned _____

Date

JUN 22 1949

19

S. J. LEWIS

Scout