


Section 34 Township 13 Range 17W

Well No. #3 Braun

Company El Dorado Ref.

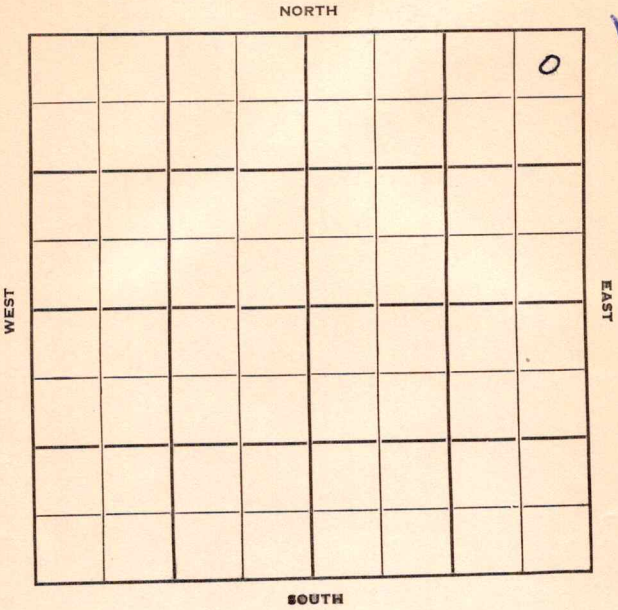

Ellis

KANSAS

Sec. 34 Twp. 13 R. 17W

Well No. #3 Braum Farm

Eldorado Refg. Company

Contractor


Toulon Pool

330 Ft. from N. Line

_____ Ft. from S. Line

330 Ft. from E. Line

_____ Ft. from W. Line

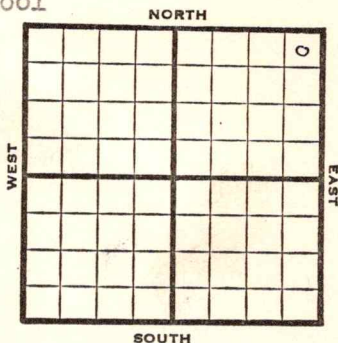

NE NE NE

1951

Elev. 1978'

REPORT

10/24
12/12

Location
 Spud 10-23-51
 Oil Well TD 3533
 8" @ 350
Heeb 3212 Tor. 3228
Ians. 3260
 DST 3270-90 open 1 hr.
 Rec. 58' mud & wtr.
 DST 3318-40 open 1 hr.
 Rec. 8' mud & 4' oil
 DST 3388-3400 open 1 hr.
 Rec. 45' SOCM
Arb. 3502 TD 3508 5" @ 3505
 CO to 3528 B/ 1/2 BOPH DD 3533
 S/ 1 1/2 BOPH 2 hr. 1000 A S/ 2 1/2 BOPH
 5 hr. Comp. 50 BOPD

COMPLETED

County Ellis State Kansas

Sec. 34 (Blk. 13) (Sur. 17W) Map No.

Operator ElDorado Ref.

Well No. 3 Farm Braun

Elev. 1978 Location NE NE NE

330 Ft. From N Line NE
330 Ft. From E Line Quarter

Ist. Report

Completion DEC 1 2 1951

Remarks Toulon Pool

Spudding Date 10-23-51

Drlg. Data Oil well TD 3533

8" @ 350 Heeb. 3212 Tor. 3228

Lans. 3260 DST 3270-90 open 1 hr.

Rec. 58' mud & water DST 3318-40

open 1 hr. Rec. 8' mud & 4' oil

DST 3388-3400 open 1 hr. Rec. 45' socm

Arb. 3502 TD 3508 5" @ 3505

CO to 3528 B/ 1/2 boph DD 3533

S/ 1 1/2 boph 2 hr. 1000 A S/ 2 1/2 boph

5 hr. Comp. 50 bopd

J. E. TYRA