


Section 35 Township 34 Range 2E

Well No. # 2 Higbee

Company O. H. Parker

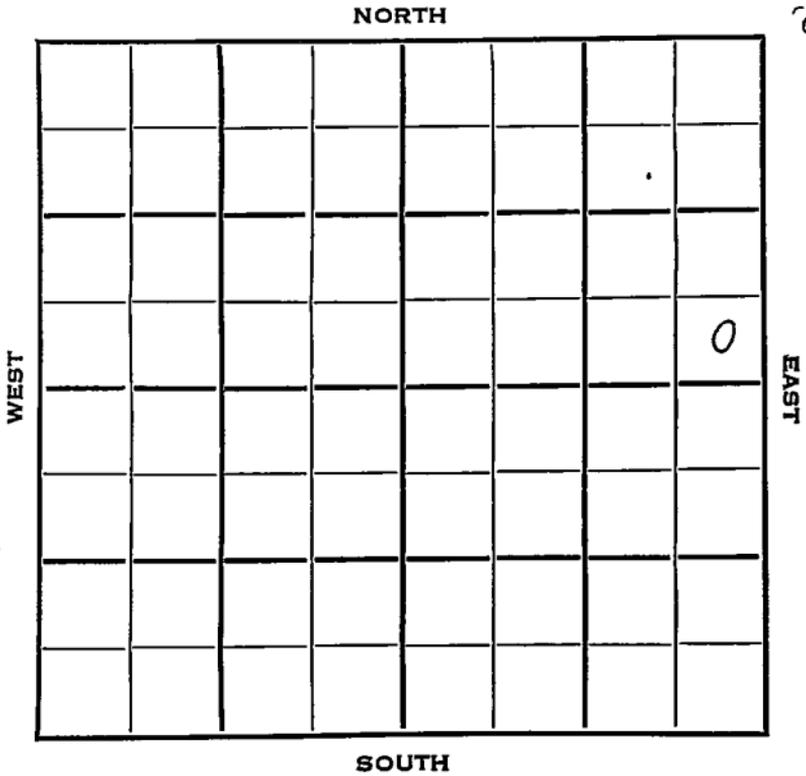

Sumner KANSAS

SEC.	TWP.	R.
35	34	2E ✓

WELL NO 2 Higbee FARM

COMPANY O. H. Parker

CONTRACTOR Martin & Cash


Hilltop Pool

\_\_\_\_\_ Ft. from N. Line

330 \_\_\_\_\_ Ft. from S. Line

330 \_\_\_\_\_ Ft. from E. Line

\_\_\_\_\_ Ft. from W. Line

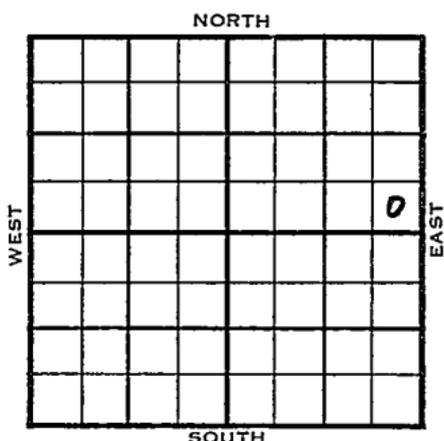

SE SE NE

1953	ELEVATION 1229'	REPORT
------	--------------------	--------

12/2 Spud 11-23-53  
8" @ 107'  
Stal. 2377', Layton 2809'  
DST 2792-2813', gas in 5 mins.,  
3/4 mcfg, taking DST

1954  
3/31 Spud 11-23-53 Oil well TD 2822  
8" @ 107' Stal. 2377' Layton 2809  
DST 2792-2813 gas in 5 min, 3/4 MCFG  
Stal. 2359 Hogshooter lime 2786  
Layton 2804  
DST 2812-17 open 2 hr rec 5' oil  
55' O & GCM 690# TD 2822  
6" @ 2807 CO to 2822 frac. 44 BOPD  
dec. to 22 BOPD  
Comp. 19 BOPD

**COMPLETED**

County Sumner State Kansas <sup>17522</sup>

Sec. 35 (Blk. Twp.) 34 (Sur. Rge.) 2E Map No.

Operator O. H. Parker

Well No. 2 Farm Higbee

Elev. \_\_\_\_\_ Location SE SE NE


330 Ft. From S Line NE

330 Ft. From E Line Quarter

1st. Report DEC 2 1953

Completion \_\_\_\_\_

Remarks \_\_\_\_\_

Martin & Cash - Contr.

Spudding Date 11-23-53

Drig. Data Hilltop Pool

8" @ 107 Stal. 2377 Layton 2809

DST 2792-2813 gas in 5 min. 3/4 mcf/g

taking DST

County Summer State KansasSec. 35 (Blk.  
Twsp.) 34 (Sur.  
Rge.) 2E Map No.Operator O. H. ParkerWell No. 2 Farm HigbeeElev. 1229 Location SE SE NE


**COMPLETE**

0

330 Ft. From S Line NE330 Ft. From E Line Quarter

1st. Report

Completion MAR 31 1954Remarks Hilltop PoolMartin & Cash - Contr.Spudding Date 11-23-53Drlg. Data Oil well TD 28228" @ 107 Stal. 2377 Layton 2809DST 2792-2813 gas in 5 min. 3/4 mcfgStal. 2359 Hogshooter lime 2786Layton 2804 DST 2812-17 open. 2 hr.Rec. 5' oil 55' o & gcm 690#TD 2822 6" @ 2807 CO to 2822 frac44 bopd dec. to 22 bopdComp. 19 bopd

J. G. MCGEHEE