

Saline


O.W.W.O.

KANSAS

Section 17 Township 16 Range 3W

Well No. 1 Swenson "B"


Company Toklan Oil
National Assec. Pet.

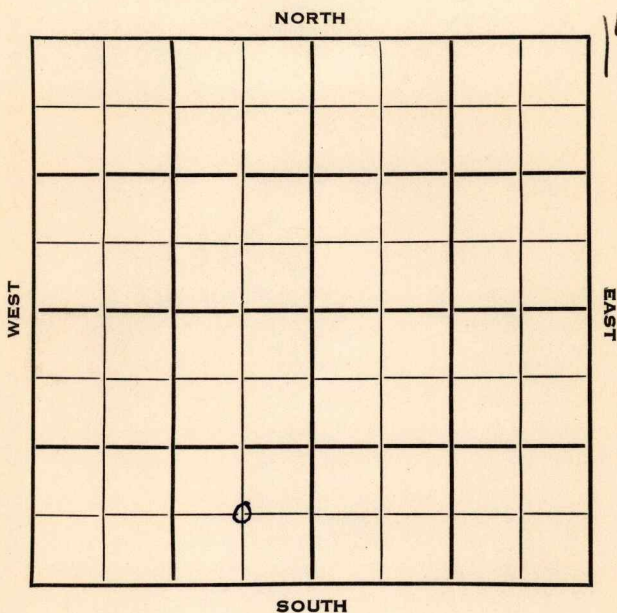

Saline KANSAS

Sec. 17 Twp. 16 R. 3 WWell No. # 2 Swenson "B" FarmNational Assoc. Pet. CompanyN. Holm Pool Contractor Ft. from N. Line660 Ft. from S. Line660 Ft. from E. Line Ft. from W. Line

C SE SW

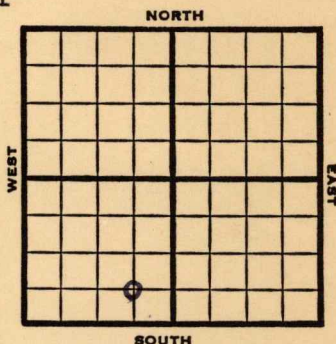

1952 Elev. 1371' REPORT

12/17	Location
12/18	Location
12/25	" "
1/1	Drlg. 1000
1/8	Miss 2936 MQ 3398 DST 3411-16
1/14	Spud 12-18-52
	D&A
	TD 3424
	10" @ 163
	8" @ 490
	Miss 2936, Maq. 3398
	DST 3411-16
	DST 3412-19, opn 2 hrs., rec.
	45' mud, 1200#
	TD 3424
	D&A

ABANDONED

County **Saline** State **Kansas**
 Sec. **17** (Blk. Twp.) **16** (Sur. Rge.) **3W** Map No.
 Operator **National Assoc. Pet.**
 Well No. **2** Farm **Swenson "B"**
 Elev. Location **C SE SW**

FIRST REPORT

660 Ft. From **S** Line **SW**

660 Ft. From **E** Line Quarter

1st. Report **DEC 17 1952**

Completion

Remarks


Spudding Date

Drlg. Data

N. Holm Pool

Location

County Saline State Kansas
 Sec. 17 (Blk. 16 (Sur. 3W Map No.
 (Twp.) (Rge.)
 Operator National Assoc. Pet.
 Well No. 2 Farm Swenson "B"
 Elev. 1371 Location C SE SW

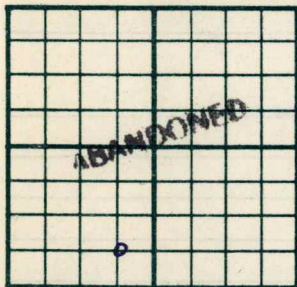

660 Ft. From S Line SW
660 Ft. From E Line Quarter

1st. Report

Completion JAN 14 1953

Remarks N. Holm Pool

Spudding Date 12-18-52

Drlg. Data D & A TD 3424

10" @ 163 8" @ 490 Miss. 2936

Mag. 3398 DST 3411-16 DST 3412-19

open 2 hr. Rec. 45' mud 1200#

TD 3424

D & A

J. G. McGEHEE

O.W.W.O.

S-513-A

CO. Saline ELEV. 1371
SEC. 17 TWP. 16 RGE. 3W
COMPANY Toklan Oil NO. 1

FIRST REPORT TO

NOV 13 57

FARM Swenson "B"

LOC. CSE SW

O.W.W.O.

O.W.O.

GEOL.

CONTR. Jackson

POOL Salemsborg

SPUD

OTD 3424 to CO

Lans. 2285

Miss. 2936

Maq. 3398

Mq. Dol. 3411

CO.

LSE.

NO.

SEC.

TWP.

RGE.

O.W.W.O.

S-513-A

CO. Saline ELEV. 1371
SEC. 17 TWP. 16 RGE. 3W
COMPANY Toklan Oil NO. 1

COMPLETE	
JAN 2 '58	
0	

FARM Swenson "B"

LOC. CSE SW

OWMO

Lans. 2285
Miss. 2936
Mag. 3398
Ma. Dol. 3411
TD 3426

GEOL.
CONTR. L.B. Jackson 8[#]

POOL Salisbury

SPUD 12-6-57

OTD 3424 to CO

NOV 20 '57 NOV 27 '57 DEC 4 '57

DEC 11 '57 8" 475/190

CO 3426 DEC 18 '57

5" 3417 CO

3426 TD Ø

53 oil

has pop

DEC 26 '57 JAN 2 '58

P 65 30+208W

pd

25 B00d 5 BW pd

CO.
LSE.
NO.
SEC.
TWP.
RGE.