


Section 17 Township 16 Range 3W

Well No. #4 Oberg

Company Atlantic Ref.

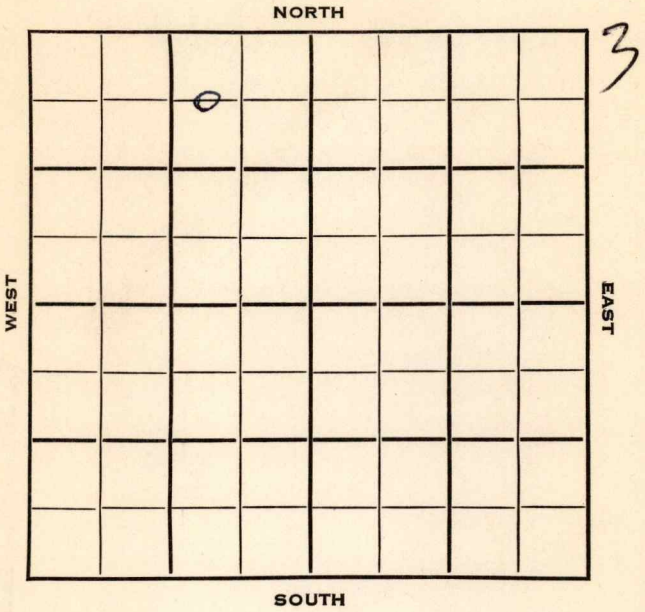

Sec. 17 Twp. 16 R. 3 W

Well No. # 4 Oberg Farm \_\_\_\_\_

Atlantic Ref. Company \_\_\_\_\_

Brack Drlg. Contractor \_\_\_\_\_

Salemsborg Pool


660 Ft. from N. Line

\_\_\_\_\_ Ft. from S. Line

990 Ft. from E. Line

\_\_\_\_\_ Ft. from W. Line

C W L N E N W

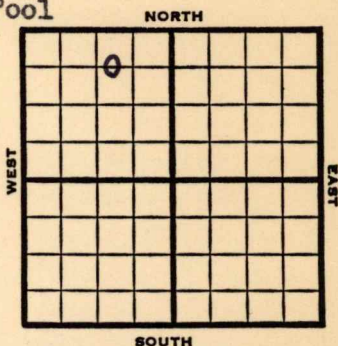

1953 **Elev. 1361'** REPORT

- 9/2 Cellar & Pits
- 9/9 8" @ 385' w/150 sks  
Drlg 1665'
- 9/16 **Br Li 2193, Lans X 2265, Miss 2924**  
**KH 3193**  
Drlg. 3330'
- 9/23 **Mq. Sha 3385' Mq. Dol 3422'**  
RTD 3425' 4" @ 3423
- 9/30 N.R.
- 10/7 CO 3425 250 A 2 BOPH sd-frac.  
S/9 BOPH & 5% wtr. POP
- 10/14 NR
- 10/28 "
- 11/4 Spud 9-2-53 Oil well TD 3425  
8" @ 385' **Br lime 2193 Lans 2265**  
**Miss 2924' Kh. 3193 Maq. sh. 3385**  
**Maq. dol. 3422 TD 3425 4" @ 3423**  
CO to 3425 250 A 2 BOPH sd-frac.  
S/9 BOPH 5% wtr.  
Comp. 38 BOPD 29 BW

**COMPLETED**



