


Section 34 Township 13 Range 17 W

Well No. # 5 Braun "A"

Company Elreco & Anschutz

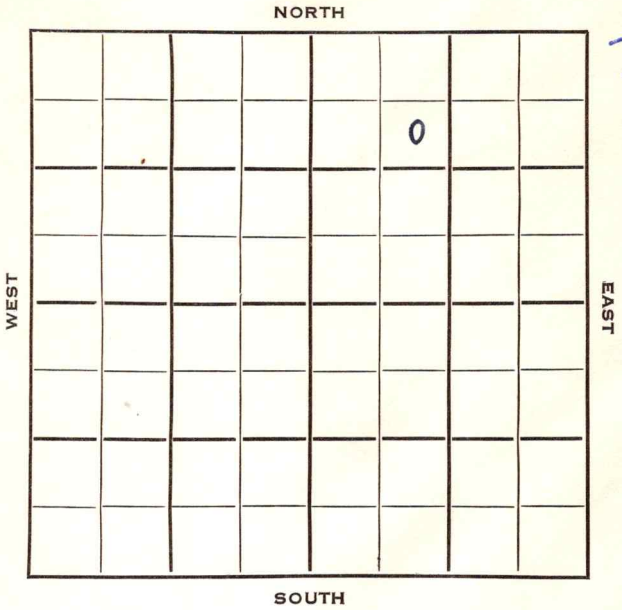

Sec. 34 Twp. 13 R. 17W

Well No. #5 Braun "A" Farm \_\_\_\_\_

Elreco & Anschutz Company

Anschutz Contractor

Toulon Pool


990 Ft. from N. Line

\_\_\_\_\_ Ft. from S. Line

\_\_\_\_\_ Ft. from E. Line

990 Ft. from W. Line

SE NW NE

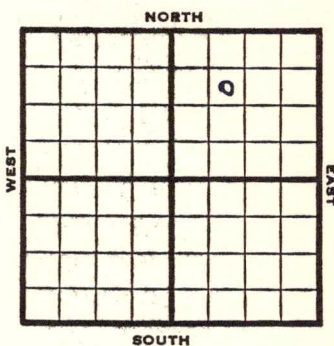

1953 **Elev. 1968'** REPORT

5/13 Spud 5-6-53  
8" @325  
**Anhy 1155**  
Drlg. 2380'

5/21 **Heeb 3179 Tor 3199 Lans 3226**  
DST 3318-27, 1 hr, 30' SO & GCM, 240#  
DST 3354-78, 1 hr, 65' VHO & GCM 975#  
DST 3400-3432, 1 hr, 90' VHO & GCM  
975# **Arb. 3470** RTD 3473 5" @ 3471

5/28 DD 3486 SSO 500 A 3 goph DD 3496  
1000 S/ 1 1/2 Boph 8 Hrs. sd-frac.

6/3 Spud 5-6-53  
Oil Well  
TD 3496'  
8" @ 325'  
**Lans 3226,**  
DS<sup>T</sup> 3318-27 opn 1 hr, rec 30' so & gcm  
240#  
dST 3354-78 opn 1 hr, rec 65' vho & gcm  
975#  
DST 3400-32 opn 1 hr, rec 90' vho & gcm  
975# **Arb 3470,**  
TD 3473  
5" @ 3471'  
CO to 3473 DD 3486 500 A 3 goph  
DD 3496 DD 3496 1000 A

**OVER**

1953

726418

Information brought forward.

6/3 S/  $1\frac{1}{2}$  boph 8 hr. sd-frac. S/  $3-\frac{3}{4}$   
boph 5 hr. PB 3445 18/ 3400-13  
27/ 3406-10 1000 A S/ 15  $\frac{3}{4}$  boph  
Comp 100 bopd

**COMPLETED**

726418



