
FORM 51 25M 3-49 PETROL Saline

KANSAS

Section 17 Township 16 Range 3W

Well No. #1 Johnson

Company Phillips & Sandus

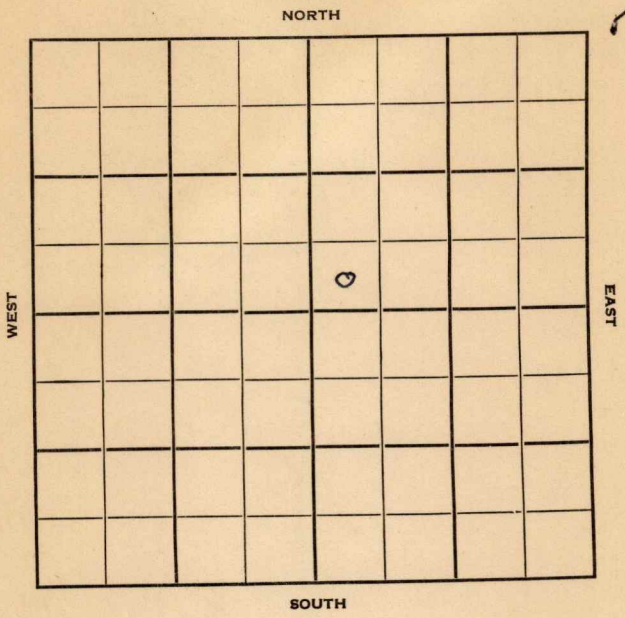

FORM 252-B
10M 8-51 TPCO.

Saline KANSAS ✓

Sec. 17 Twp. 16 R. 3W

Well No. #1 Johnson Farm

Phillips & Sandeson Company

Carey Drlg. Contractor


Ft. from N. Line

330 Ft. from S. Line

Ft. from E. Line

330 Ft. from W. Line

NE¼ SW SW NE

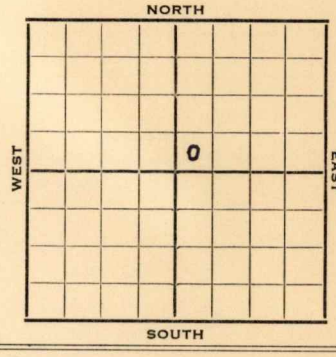

1952	REPORT
	Elev. 1353'
10/29	Spud 10-24-52 8" @ 310' Drlg. 926'
11/5	Miss. 2926' Drlg. 3110'
11/12	Spud 10-24-52 D & A TD 3413' 8" @ 310 Miss 2898' KH. 3160' Maq. sh. 3319' Maq. dol. 3388' DST 3389-3413 open 1 hr. rec 15' mud & VSSO 60# TD 3413' D & A ABANDONED

FORM 275 FOR SALE BY KANSAS BLUE PRINT CO.


County Saline State Kansas

Sec. 17 (Blk. Twp.) 16 (Sur. Rge.) 3W Map No.

Operator Phillips & Sanderson

Well No. 1 Farm Johnson

Elev. 1353 Location SW SW NE

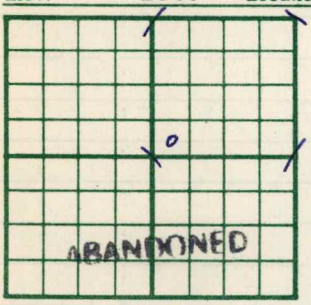

330 Ft. From S Line NE

330 Ft. From W Line Quarter

1st. Report

Completion NOV 1 2 1952

Remarks

Carey Drlg. - Contr.

Spudding Date 10-24-52

Drlg. Data D & A TD 3413

8" @ 310 Miss. 2898 Kh. 3160

Mag. sh. 3319 Mag. dol. 3388 DST 3389-3413 open 1 hr. Rec. 15' mud & VSSO 60# TD 3413

D & A

J. G. McGEHEE

FORM 275 FOR SALE BY KANSAS BLUE PRINT CO.


County Saline State Kansas

Sec. 17 (Blk. Twp.) 16 (Sur. Rge.) 3W Map No.

Operator Phillips & Sandus

Well No. 1 Farm Johnson

Elev. Location SW SW NE

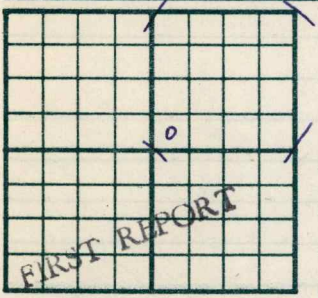

330 Ft. From S Line NE

330 Ft. From W Line Quarter

1st. Report OCT 29 1952

Completion

Remarks Carey Drlg. - Contr.

Spudding Date 10-24-52

Drlg. Data

8" @ 310 drlg. 926

J. G. McGEHEE