FORM 51 5M 2-38 TPCO.


Saline

KANSAS

Section 28 Township 16 Range 3-W

Well No. 1 Erickson

Company Jess Cling ~~Sullivan & Sidwell~~

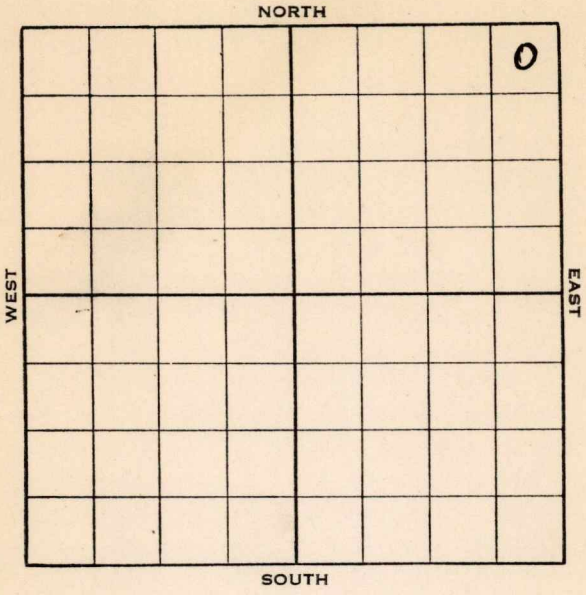


O. W. D. D

FORM 252-A 5M 1-38 KANSAS Saline

Sec. 28 Twp. 16 R. 3-W

Well No. #1 Erickson Farm


Jess Cling
~~Sullivan & Sidwell~~ Company

330 Ft. from N. Line

Ft. from S. Line

330 Ft. from E. Line

Ft. from W. Line

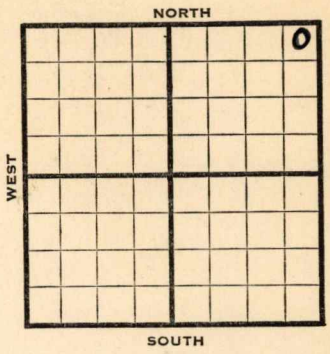


Elev. 1330'

| 1938 | REPORT O. W. D. D |
|---|---|
| 6/8 | ROG. |
| 6/17 | C.R. |
| 6/24 | " |
| 7/1 | " |
| 7/8 | " |
| 7/15 | " |
| 7/22 | " |
| 7/29 | " |
| 8/5 | S. H. (Rotary tools) |
| 8/12 | 10" - 176'. T.D. 301'. |
| | Fighting cave. |
| 8/19 | Dlg. 1360'. |
| 8/26 | Topeka 1704'. |
| | SD 1750'. |
| 9/2 | " " |
| 9/9 | SD 1764'. |
| 9/16 | " " |
| 9/23 | " " |
| 9/30 | " " |
| 10/7 | " " |
| | |
| 10/12 | T. D. 1764'. |

ABANDONED

O. W. D. D

1939

8/23 Old T.D. 1764'
Drilling 1783' (Rotary)
Old hole drilled by.

8/31 Lans. 2218' Drlg. 2577'

9/7 No report.

9/13 Lans. 2218'
Viola 3330'
T.D. 3375'

ABANDONED

Form 26—1M Bks.—2-29

Saline KANSAS

Map No. 42 Sec. 28 Twp. 16 R. 3W

Well No. 1 Erickson

Sullivan & Sidwell Company

Contractor

FIRST REPORT

NE/C


330 Ft. from N. Line

Ft. from S. Line

330 Ft. from E. Line

Ft. from W. Line

SECTION PLAT

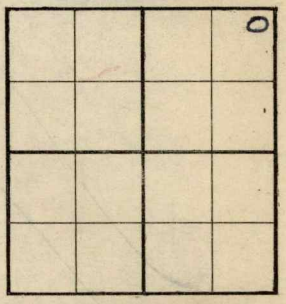

Location

Rig up

Drilling and Remarks:

ROG

RECORD

Cased in., ft.

Sand

Gas

Oil

Total Depth

PRODUCTION

1st 24 hrs. Nat.

1st 24 hrs. after shot

Gas Cu. Ft.

Dry Hole

Abandoned

Date

JUN 8 - 1938 19

H. D. Hatfield Scout

Form 26—1M Bks.—2-29 Saline KANSAS

Map No. 42 Sec. 28 Twp. 16 R. 3W

Well No. 1 Erickson

Sullivan & Sidwell Company

Contractor

ABANDONED
NE/C


330 Ft. from N. Line

Ft. from S. Line

330 Ft. from E. Line

Ft. from W. Line

**SECTION PLAT**

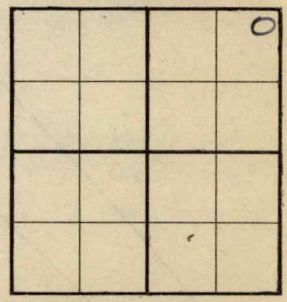

Location

Rig up

Drilling and Remarks:

abd

**RECORD**

Cased in., ft.

Sand

Gas

Oil

Total Depth 1764

**PRODUCTION**

1st 24 hrs. Nat.

1st 24 hrs. after shot

Gas Cu. Ft.

Dry Hole

Abandoned

Date

OCT 12 1938 19

H. D. Hatfield Scout

Form 26—1M Bks.—2-29 KANSAS Saline

Map No. 42 Sec. 28 Twp. 16 R. 3W.

Well No. 1 Erickson

Jess C Ling Company

Contractor

NE/c

FIRST REPORT


330 Ft. from N. Line

Ft. from S. Line

330 Ft. from E. Line

Ft. from W. Line

**SECTION PLAT**

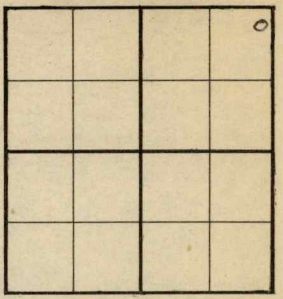

Wild Cat

Location

Rig up

Drilling and Remarks:

OWDD.
Old TD 1764
Rotary drilling
1783
Old hole abandoned
by
Sullivan & Stroup

**RECORD**

Cased in., ft.

Sand

Gas

Oil

Total Depth

**PRODUCTION**

1st 24 hrs. Nat.

1st 24 hrs. after shot

Gas Cu. Ft.

Dry Hole

Abandoned

Date

AUG 23 1939 19 S. J. LEWIS Scout

Form 26—1M Bks.—2-29 Saline KANSAS

Map No. 42 Sec. 28 Twp. 16 R. 3W

Well No. 1 Erickson

Jess Cling Company

Contractor

ABANDONED

NE/C

330 Ft. from N. Line


Ft. from S. Line

330 Ft. from E. Line

Ft. from W. Line

WILDCAT

**SECTION PLAT**

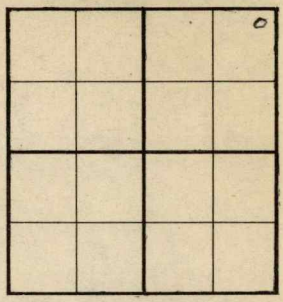

Location

Rig up

Drilling and Remarks:

Lans 2218

Viola 3330-

**RECORD**

Cased in., ft.

Sand

Gas

Oil

Total Depth 3375

**PRODUCTION**

1st 24 hrs. Nat.

1st 24 hrs. after shot

Gas Cu. Ft.

Dry Hole

Abandoned

Date

SEP 13 1939 19

S. J. LEWIS Scout