

Sec. 32 Twp. 16 R. 13W

Well No. #6 Schriber Farm
Continental Company
Susank


990 Ft. from N. Line

 Ft. from S. Line

330 Ft. from E. Line

 Ft. from W. Line

SE NE SE

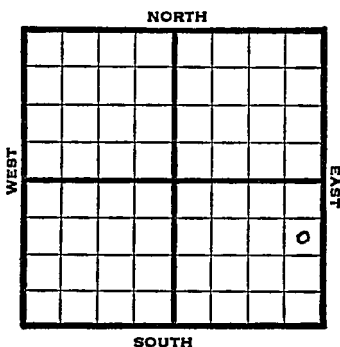

1947	Elev.	REPORT	1929'
------	-------	--------	-------

7/23	Location		
------	----------	--	--

7/29	"		
------	---	--	--

8/6	Drlg 2056'		
-----	------------	--	--

8/13	Arbuckle 3389-95 TD 7" @ 3389' RUST		
------	---	--	--

8/20	Arbuckle 3383 corrected 7" @ 3383 TD 3391'		
------	--	--	--

8/27	Arbuckle 3383' 7" @ 3383'		
------	------------------------------	--	--

Pump 96 oil & 7% W Pot
Total Depth 3391'

COMPLETED

Map No. **Kansas** Sec. 32 Twp. 16 R. 13W

Well No. 6 Schriber

Continental Company

FIRST REPORT

Contractor

SE NE SE

SECTION PLAT

990 Ft. from N. Line

 Ft. from S. Line

330 Ft. from E. Line

 Ft. from W. Line

Barton County

Location X

Rig up

Drilling and Remarks:

RECORD

Cased in., ft.

Sand

Gas

Oil

Total Depth

PRODUCTION

1st 24 hrs. Nat.

1st 24 hrs. after shot

Gas Cu. Ft.

Dry Hole

Abandoned

Date

JUL 23 1947

19

S. J. LEWIS

Scout

Map No. 73 Sec. 32 Twp. 16 R. 13W

Well No. 6 Schriber

Continental Company

COMPLETE

Contractor

SE NE SE

E. 1929
SECTION PLAT

990 Ft. from N. Line

 Ft. from S. Line

330 Ft. from E. Line

 Ft. from W. Line

Barton County

Location _____

Rig up _____

Drilling and Remarks:

Ar 3383

7" 3383

Only 96 oil + 17%

W. J. L.

(96 oil)

RECORD

Cased _____ in., _____ ft.

Sand _____

Gas _____

Oil _____

Total Depth *2391*

PRODUCTION

1st 24 hrs. Nat. _____

1st 24 hrs. after shot _____

Gas _____ Cu. Ft.

Dry Hole _____

Abandoned _____

Date

AUG 27 1947

19

S. J. LEWIS

Scout