

KANSAS


FORM 51 5M 1-42 PETROL

Barton

Section 32 Township 16 Range 13-W

Well No. #2 F. J. Schrieber

Company Continental

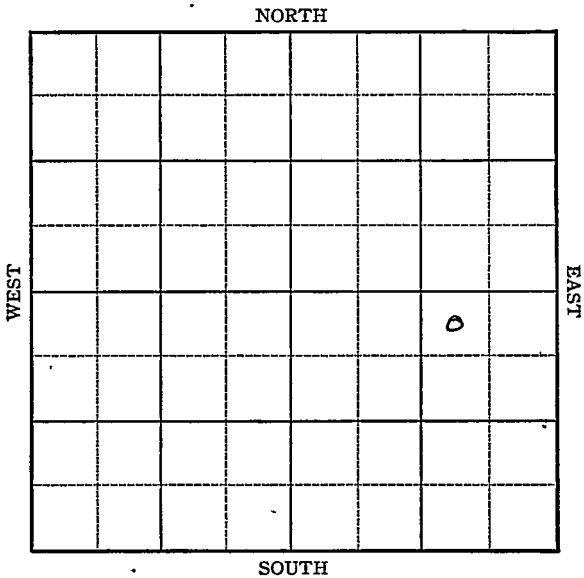

Sec. 32 Twp. 16 R. 13-W

Well No. #2 F. J. Schrieber Farm


Continental Company

330 Ft. from N. Line

_____ Ft. from S. Line

990 Ft. from E. Line

_____ Ft. from W. Line

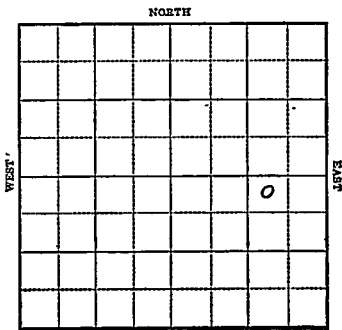

Elev. ~~1425~~ 1913

1943

R E P O R T

9/29	Derrick
10/6	"
10/13.	"
10/20	"
10/27	"
11/3	10" @ 360 WOC.
11/10	Drlg. 2565
11/17	Arb 3345 TD 3364 6" @ 3346 RUST
11/24	2600' oil CO
12/1	Swb 90 oil in 1-1/3 hrs.
12/8	" "
12-15	" "
12/29	" "
1944	
1-5	" " "
1-12	" " "
1/19	" -
1/26	" "
	" -
2/2	" "

OVER

1944

2/8¹/₂

Swb 90 oil in 11/3 hrs.

2/16

6" @ 3346

Arb 3345

TD 3364

Pump 323 Pot.

Gravity 41

COMPLETED

Map No. KANSAS 73 Sec. 32 Twp. 16 R. 13W

Well No. 2 F. J. Schrieber

Continental Company

COMPLETED Contractor

NW NE SE

SECTION PLAT

330 Ft. from N. Line

_____ Ft. from S. Line

990 Ft. from E. Line

_____ Ft. from W. Line

			o

Ainsworth Pool

Location _____

Rig up _____

Drilling and Remarks:

Per 83345.

6" @ 83346.

Pump 323 Per 8.

41° SW

RECORD

Cased _____ in., _____ ft.

Sand _____

Gas _____

Oil _____

Total Depth 3364'

PRODUCTION

1st 24 hrs. Nat. _____

1st 24 hrs. after shot _____

Gas _____ Cu. Ft.

Dry Hole _____

Abandoned _____

Date

FEB 16 1944 19

S. J. LEWIS Scout