

Ellis


KANSAS

SECTION 34 TOWNSHIP 13 S RANGE 17 W

WELL NO. # 1 Dreiling

COMPANY K & E Drlg.

NORTH NE NW NW

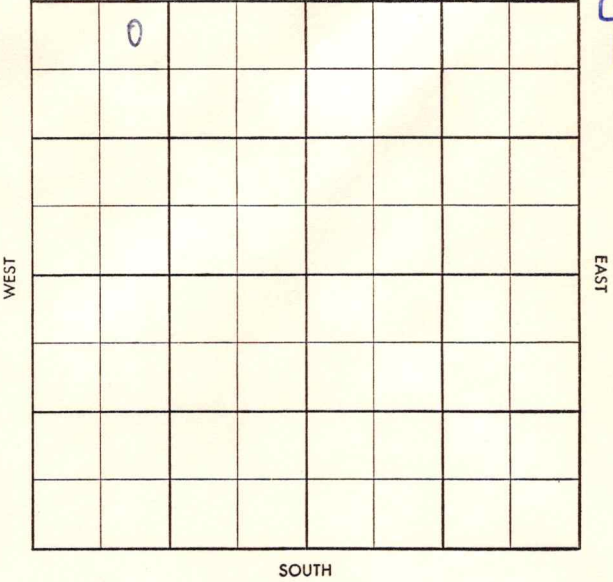

~~Foot...~~ ~~Foot...~~ ~~Foot...~~  
NO  
FOOT

County Ellis Elev. \_\_\_\_\_  
Sec. 34 Twp. 13S Rge. 17W  
Company K. & E. Drlg.  
Farm Name Dreiling No. 1

TOPS	DEPTH	LOG	DATUM
Anh.			
Tp.			
H.			
Tr.			
Dg.			
B.L.			
L.			
K.C.			
B.K.C.			
Ce.			
C.			
M.			
M.			
K.			
Mz.			
Mq.			
V.			
S.			
S.			
A.			
R.			
Pf.			
G.			
T.D.			

Loc. in Sec. NE NW NW  
Geol. Brinegar  
Contr. Co.  
Tools Rig 2  
Pool \_\_\_\_\_

FIRST REPORT  
SEP 3 '58

Date Comm. 8/31/58  
8" @ 179 w/140, Drlg 1185

Co.  
Lse.  
No.  
Sec.  
T.  
R.

Tw. \_\_\_\_\_ Pool \_\_\_\_\_

Co. \_\_\_\_\_ Facet \_\_\_\_\_

S-513-B

County Ellis Elev. 1955 OF 1958 RB  
 Sec. 34 Twp. 13S Rge. 17W  
 Company K. & E. Drlg.  
 Farm Name Dreiling No. 1

TOPS	DEPTH	LOG	DATUM	Loc. in Sec.
Anth.				NE NW NW
Tp.				
H.	<u>3207</u>			
Tr.	<u>3226</u>			
Dg.				
B.L.				
L.	<u>3252</u>			Geol. <u>Brinegar</u>
K.C.				Contr. <u>Co.</u>
B.K.C.	<u>3485</u>			<u>Tools Rig 2</u>
Ce.				Pool _____
C.				<u>Sugarleaf SE</u>
M.				
M.				
K.				
Mz.				
Mq.				
V.				
S.				
S.				
A.				
R.				
Pf.				
G.				
T.D.	<u>3560</u>			

o  
 ABANDONED  
 SEP 17 '58

Date Comm. 8/31/58  
8" @ 179 w/140, Drlg 1185 SEP 10 '58  
 SEP 17 '58

TD in sh  
 in congl

D&A

726455

E1 1955

TD 1605