


Section 20 Township 16 Range 3W

Well No. #3 Holm

Company Atlantic Refg.

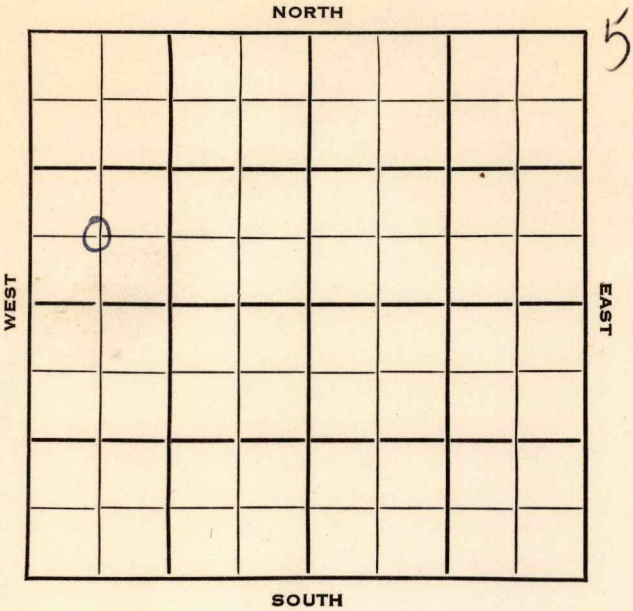

Saline

KANSAS

Sec. 20 Twp. 16 R. 3WWell No. #3 Holm Farm

Atlantic Ref.

Company

Contractor

N. Holm Pool

Ft. from N. Line

660


Ft. from S. Line

Ft. from E. Line

660

Ft. from W. Line

C SW NW

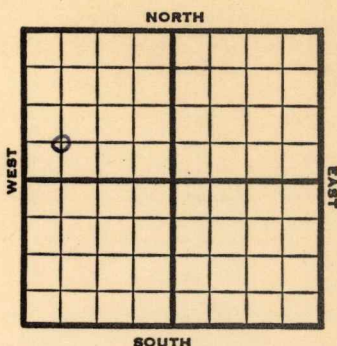

1953

Elev. 1379'

REPORT

4/22

Location

4/30

8" @ 381

Drlg. 1210'

5/7

Br. L. 2230, Lans 2301, Burgess 2951,
Miss 2955, Kh. 3214, Meisner 3405, Mg
sho 3409, Mg dol 3443,

RTD 3445

4" @ 3444'

5/21

Testing

5/28

"

6/10

Spud 4-24-53

Oil Well

TD 3446'

8" @ 381'

Br. Lime 2230, Lans 2301, Miss 2951,
Kh 3210, Misener 3401, Maq. sh. 3405,
Maq. dol. 3439,

TD 3441'

4" @ 3440'

DD 3442 $\frac{1}{2}$ goph 500 A S/ $\frac{1}{2}$ bophDD 3446 1500 A S/ 1 boph S/ $1\frac{1}{2}$ bfph50% wtr. S/ 1 boph $\frac{1}{2}$ bw P/ 41 bopd

4 bw.

Comp 37 bopd.

COMPLETED

County

Saline

State

Kansas

Sec.

20

(Blk.)
(Twp.)

16

(Sur.)
(Rge.)

3W

Map No.

Operator

Atlantic Ref.

Well No.

3

Farm

Holm

Elev.

Location

C SW NW


660

Ft. From

S Line

NW

660

Ft. From

IV Line

Quarter

1st. Report

APR 22 1953

Completion

Remarks

Spudding Date

Drlg. Data

N. Holm Pool

Location

J. G. McGEHEE

County Saline State Kansas
 Sec. 20 (Blk. Twp.) 16 (Sur. Rge.) 3W Map No. _____
 Operator Atlantic Ref.
 Well No. 3 Farm Holm
 Elev. 1379 Location C SW NW



660 Ft. From S Line NW
 660 Ft. From W Line Quarter

1st. Report _____

Completion JUN 10 1953

Remarks N. Holm Pool

Spudding Date 4-24-53

Drlg. Data Oil well TD 3446

8" @ 381 Br. lime 2230 Lans. 2301

Miss. 2951 Kh. 3210 Misener 3401

Maq. sh. 3405 Maq. dol. 3439

TD 3441 4" @ 3440 DD 3442 $\frac{1}{2}$ goph

500 A S/ $\frac{1}{2}$ boph DD 3446 1500 A

S/ 1 boph S/ $1\frac{1}{2}$ bfph 50% wtr.

S/ 1 boph $\frac{1}{2}$ bw P/ 41 bopd 4 bw

Comp. 37 bopd

J. G. McGEHEE