


Section 34 Township 13 Range 17 W

Well No. # 1 E. Dreiling

Company Champlin

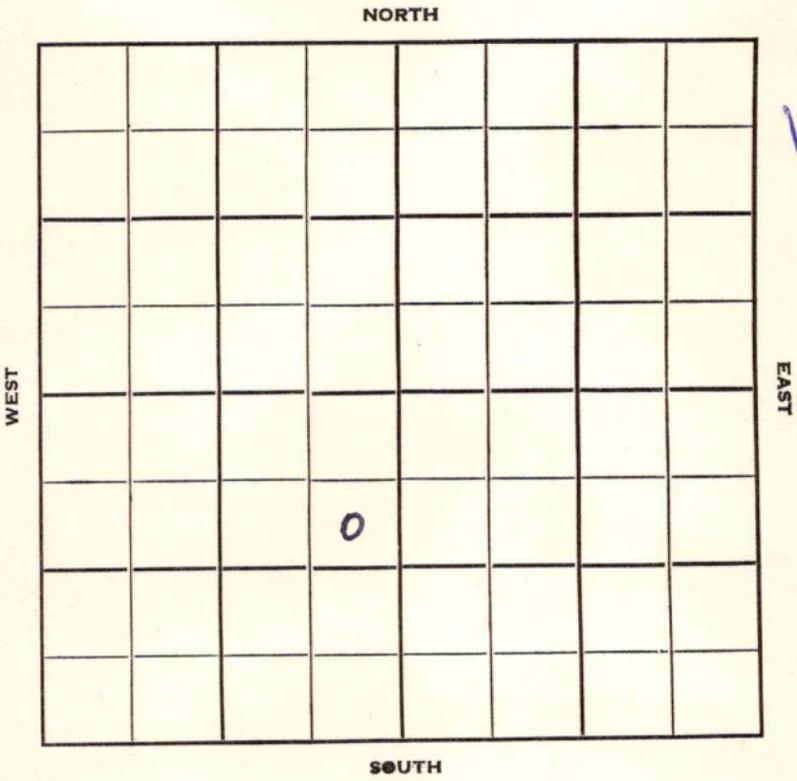

Sec. 34 Twp. 13 R. 17W

Well No. #1 E. Drelling Farm

Champlin Company

Champlin Contractor


990 Ft. from N. Line

_____ Ft. from S. Line

330 Ft. from E. Line

_____ Ft. from W. Line

SE NE SW

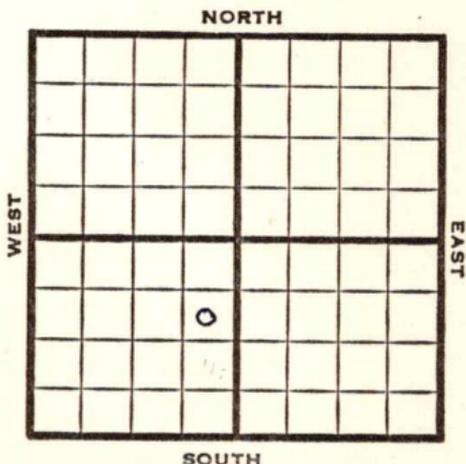

1952

Elev. 1949' REPORT

8/13

MIR

8/20

8" @ 172' **Anhy 1170'**
Dräg 2477'

8/27

Heeb. 3194 Lans. 3243
DST 3410-26 1 hr. 8' M
RTD 3564

9/4

Spud 8-14-52
D&A TD 3547' 8" @ 172
Anhy 1170 Heeb. 3194
Tor. 3214 Lans. 3243
DST 3410-26 open 1 hr. rec. 8' mud
DST 3302-27 open 1 hr. rec. 65' sw
750# **Arb. 3531'** TD 3547' D&A

ABANDONED


County **Ellis** State **Kansas**

Sec. **34** (Blk. Twp.) **13** (Sur. Rge.) **17W** Map No.

Operator **Champlin**

Well No. **1** Farm **E. Dreiling**

Elev. Location **SE NE SW**

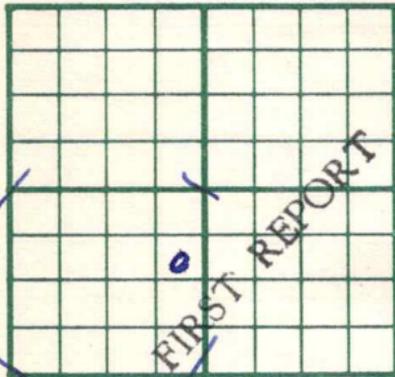

990 Ft. From **N** Line **SW**

330 Ft. From **E** Line Quarter

1st. Report **AUG 13 1952**

Completion

Remarks

Champlin - Contr.

Spudding Date

Drlg. Data

MIR

J. G. McGEHEE


County Ellis State Kansas

Sec. 34 (Blk. 13) (Sur. Rge.) 17W Map No.

Operator Champlin Ref.

Well No. 1 Farm E. Dreiling

Elev. 1949 Location SE NE SW

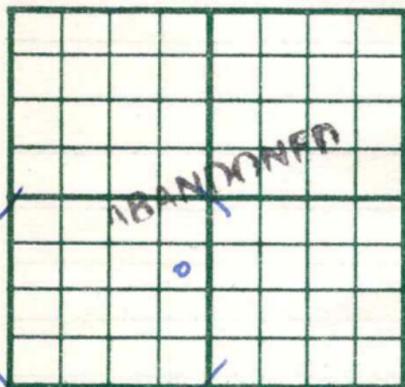

990 Ft. From N Line SW

330 Ft. From E Line Quarter

Ist. Report

Completion SEP 4 1952

Remarks

Champlin - Contr.

Spudding Date 8-14-52

Drlg. Data D & A TD 3547

8" @ 172 Anhy 1170 Heeb. 3194

Tor. 3214 Lans. 3243 DST 3410-26

open 1 hr. Rec. 8' mud DST 3302-27

open 1 hr. Rec. 65' sw 750#

Arb. 3531 TD 3547

D & A