


Section 20 Township 16 Range 3 W

Well No. # 2 Swenson "C"

Company National Assoc. Pet.

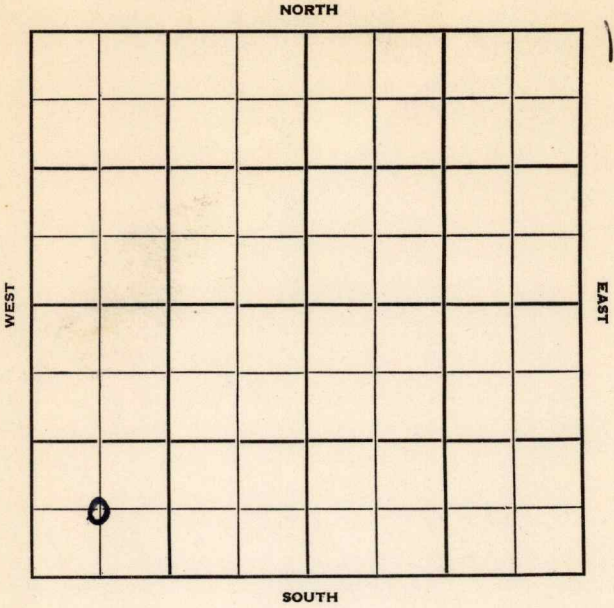



Sec. 20 Twp. 16 R. 3 W

Well No. # 2 Swenson "C" Farm

National Assoc. Pet. Company

National Assoc. Contractor

Salemborg Pool

Ft. from N. Line

660


Ft. from S. Line

Ft. from E. Line

660

Ft. from W. Line

C SW SW

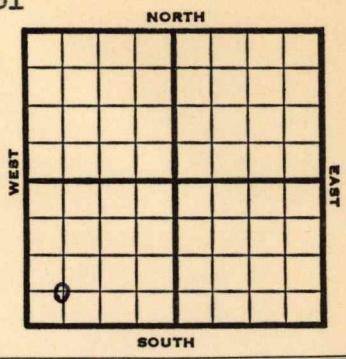

1953

Elev. 1397'

REPORT

6/17

Spud 6-13-53
10" @ 157 8" @ 409 WOC

6/24
7/1

Drlg. 2570'
Miss 2923, Kh 3216, Mg dol 3455
RTD 3456
5" @ 3455'

7/8

DD 3459 TD
20 goph 4 hrs., 1000A
Fish swab

7/22

Spud 6-13-53
Oil Well
TD 3459
10" @ 157
8" @ 409
Miss 2923, Kh. 3216, Maq. 3455
TD 3456
5" @ 3455
DD 3459, 20 goph, 1000A
S/2 boph & SSW 8 hrs.
St.-frac
S/3 1/2 boph
Comp. 40 bopd

COMPLETED

