


STATE OF KANSAS
STATE CORPORATION COMMISSION

Form CP-4

Give All Information Completely
Make Required Affidavit
Mail or Deliver Report to:
Conservation Division,
State Corporation Commission
211 No. Broadway
Wichita, Kansas

WELL PLUGGING RECORD

NORTH

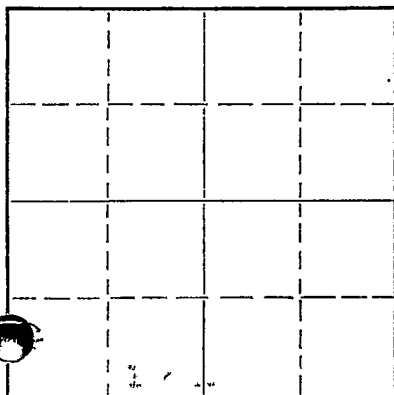

Locate well correctly on above
Section Plat

Neosho County. Sec. 19 Twp. 28S Rge. 18E (E) (W)
Location as "NE/CNW/SW" or footage from lines SE SW NE
Lease Owner Kenneth C. Reas
Lease Name Daley Well No. 6
Office Address Box 556, Chanute, Kansas 66720
Character of Well (completed as Oil, Gas or Dry Hole) Dry hole
Date well completed 9-14-65 19
Application for plugging filed 9-14-65 19
Application for plugging approved 9-14-65 19
Plugging commenced 9-14-65 19
Plugging completed 9-14-65 19
Reason for abandonment of well or producing formation Dry hole
If a producing well is abandoned, date of last production 19
Was permission obtained from the Conservation Division or its agents before plugging was commenced? Yes

Name of Conservation Agent who supervised plugging of this well Vic Simoncic
Producing formation _____ Depth to top _____ Bottom _____ Total Depth of Well 1053 Feet
Show depth and thickness of all water, oil and gas formations.

OIL, GAS OR WATER RECORDS

CASING RECORD

FORMATION	CONTENT	FROM	TO	SIZE	PUT IN	PULLED OUT
Well log on back						

Describe in detail the manner in which the well was plugged, indicating where the mud fluid was placed and the method or methods used in introducing it into the hole. If cement or other plugs were used, state the character of same and depth placed, from _____ feet to _____ feet for each plug set.

Run five sacks cement at bottom. Spot ten sacks cement at 450', set bridge at 150' and put in five sacks cement. Set bridge at 25' and put in three sacks cement. Put two sacks in rat hole.

(If additional description is necessary, use BACK of this sheet)

Name of Plugging Contractor K-K Drilling Company
Address Box 556, Chanute, Kansas 66720 License No. 573

STATE OF KANSAS, COUNTY OF NEOSHO, ss.
Kenneth C. Reas (employee or owner) or (owner or operator) of the above-described well, being first duly sworn on oath, says: That I have knowledge of the facts, statements, and matters herein contained and the log of the above-described well as filed and that the same are true and correct. So help me God.

(Signature) _____
Box 556, Chanute, Kansas 66720
(Address)

SUBSCRIBED AND SWORN TO before me this 15th day of September, 19 65

My commission expires 10-22-67

Janet Bloomer

Notary Public,