


Section 29 Township 16 Range 3W

Well No. #2 Nelson

Company National Assoc. Pet.

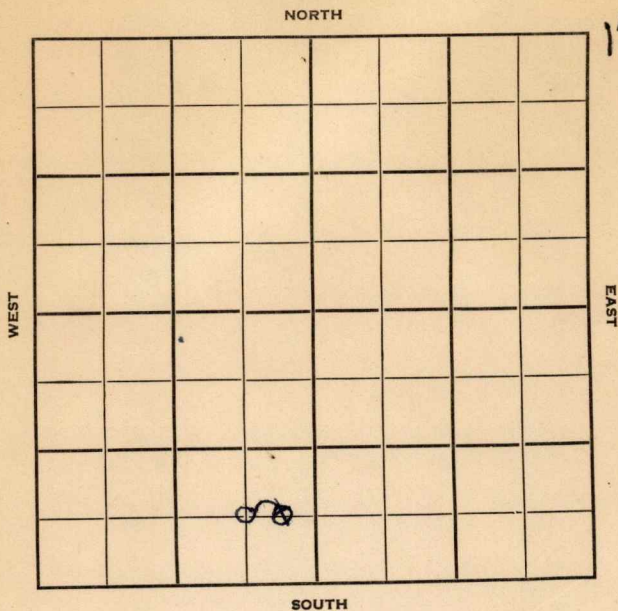

Saline

KANSAS

20

16

3W

Sec. Twp. R.

#2 Nelson

Well No. Farm

National Assoc. Pet.

Company

Holm Pool

Contractor

Ft. from N. Line

660


Ft. from S. Line

660
330

Ft. from E. Line

Ft. from W. Line

~~C E L S E S W~~
C S E S W

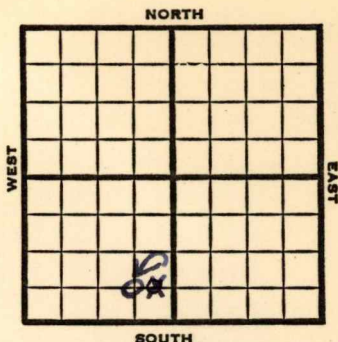

1952

Elev. 1383' REPORT

10/8

Spud 10-7-52
12" @ 150' Drlg.

10/15

8" @ 400, Drlg. 2510'

10/22

Tite Hole

10/29

RTD 3430' 5" @ 3420 CO 3430
20 gal OPH for 6 hrs. 1500 A
Schl tops: Lans. 2302' Burgess
2937' Miss 2955' KH 3198' Mq
shale 3391' Mq. Dol. 3420'.

11/5

CO 3428' mud A

11/12

Mud A-3500

11/20


NR

11/26

Spud 10-7-52
Oil well TD 3430' 12" @ 150
8" @ 400 Lans. 2302' Burgess 2937'
Miss. 2955' Kh. 3198' Maq. sh. 339
Maq. dol. 3420' TD 3430' 5" @ 3420
CO to 3428' 3500 A
Comp. 38 BOPD 3% wtr.

COMPLETED

County Saline State Kansas
 Sec. 20 (Blk. 16) (Sur. 3W) Map No. _____
 Operator National Assoc. Pet.
 Well No. 2 Farm Nelson
 Elev. 1383 Location C SE SW

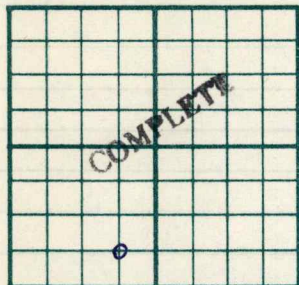

660 Ft. From S Line SW
660 Ft. From E Line Quarter
 Ist. Report _____
 Completion NOV 26 1952
 Remarks Holm Pool

Spudding Date 10-7-52

Drlg. Data Oil well TD 3430
12" @ 150 8" @ 400 Lans. 2302
Burgess 2937 Miss. 2955 Kh. 3198
Maq. sh. 3391 Maq. dol. 3420 TD 3430
5" @ 3420 CO to 3428 3500 A
Comp. 38 bopd 3% wtr.

J. G. McGEHEE

Kansas


Map No. _____ Sec. 20 Twp. 16 R. 3WWell No. 2 Nelson

National Assoc. Pet. _____ Company

CORRECTION Contractor

C SE SW

SECTION PLAT

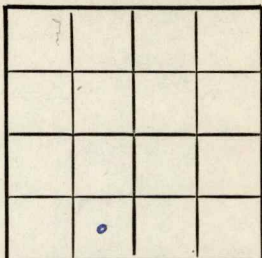

_____ Ft. from N. Line

660 Ft. from S. Line660 Ft. from E. Line

_____ Ft. from W. Line

Saline County

Location _____

Rig up _____

Drilling and Remarks:

Reported

C E L SE SW

RECORD

Cased _____ in., _____ ft.

Sand _____

Gas _____

Oil _____

Total Depth _____

PRODUCTION

1st 24 hrs. Nat. _____

1st 24 hrs. after shot _____

Gas _____ Cu. Ft.

Dry Hole _____

Abandoned _____

Date

OCT 8 1952 19J. G. McGEHEE Scout

County **Saline** State **Kansas**

Sec. 20 (Blk. Twp.) 16 (Sur. Rge.) 3W Map No.

Operator National Assoc. Pet.

Well No. 2 Farm Nelson

Elev.	Location	C E L S E SW
-------	----------	--------------

660 Ft. From S Line SW

330 Ft. From E Line Quarter

1st. Report OCT 8 1952

Completion

Remarks

Spudding Date 10-7-52

Drlg. Data Holm Pool

12" @ 150 drlg.

J. G. McGEHEE