


Section 21 Township 16 Range 3 W

Well No. # 1 Swanson

Company John H. Burgher

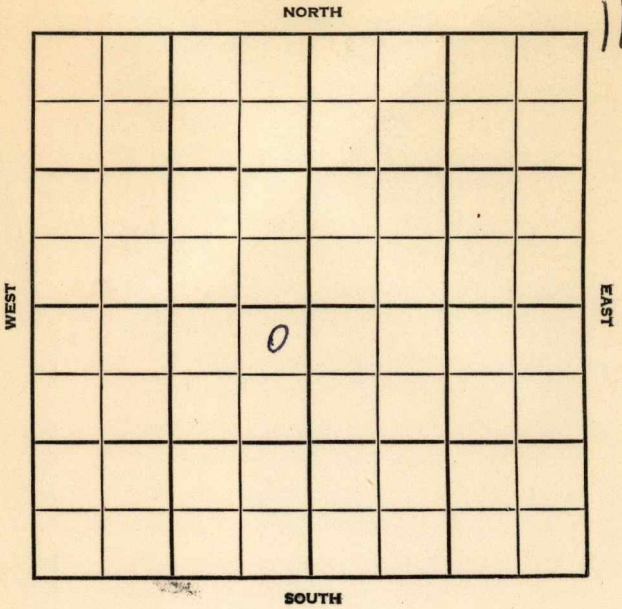

Saline KANSAS

SEC. 21 TWP. 16 R. 3W

WELL NO. 1 Swanson FARM

COMPANY John H. Burgher

CONTRACTOR Braden Drlg.


Wildcat

330 Ft. from N. Line

Ft. from S. Line

330 Ft. from E. Line

Ft. from W. Line

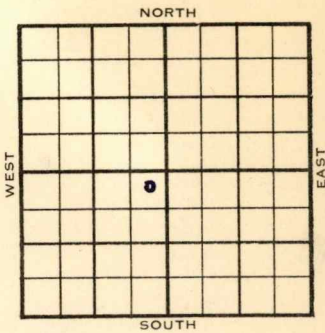

NE NE SW

1955 ELEVATION 1372' REPORT

3/16 10" @ 160', WOC

4/6 ~~Sand~~ D&A, TD 3584, 10" @ 160
 8" @ 450, Heeb 2029, Tor 2050
 Doug 2067, Br. Lime 2176, Lans
 2256, Miss 2914, Kh. 3132,
 Mag. 3362, Viola 3421, Simp.
 3504, DST 3520-47, open 45 min.
 Rec. 350' MW 1275#, Arb 3564,
 TD 3584,
 D&A

ABANDONED

County **Saline** State **Kansas**

Sec. **21** (Blk. Twp.) **16** (Sur. Rge.) **3W** Map No.

Operator **John H. Burgher**

Well No. **1** Farm **Swanson**

Elev. Location **NE NE SW**



330 Ft. From **N** Line **SW**

330 Ft. From **E** Line Quarter

Ist. Report **MAR 16 1955**

Completion

Remarks

Braden Drlg. - Contr.

Spudding Date

Drlg. Data **Wildcat**

10" @ 160 WOC

FABEN GILSTRAP

County Saline State Kansas

Sec. 21 (Blk. 16) (Sur. 3W) (Twp.) 3W Map No.

Operator John H. Burgher

Well No. 1 Farm Swanson

Elev. 1372 Location NE NE SW

ABANDONED									

330 Ft. From N Line SW

330 Ft. From E Line Quarter

1st. Report

Completion APR 6 1955

Remarks Wildcat

Braden Drlg. - Contr.

Spudding Date

Drlg. Data D & A TD 3584

10" @ 160 8" @ 450 Heeb. 2029

Tor. 2050 Doug. 2067 Br. lime 2176

Lans. 2256 Miss. 2914 Kh. 3132

Maq. 3362 Viola 3421 Simp. 3504

DST 3520-47 open 45 min. Rec. 350' mw

1275# Arb. 3564 TD 3584

D & A

FABEN GILSTRAP