


Section 32 Township 16 Range 13N

Well No. 7 Schriber

Company Continental

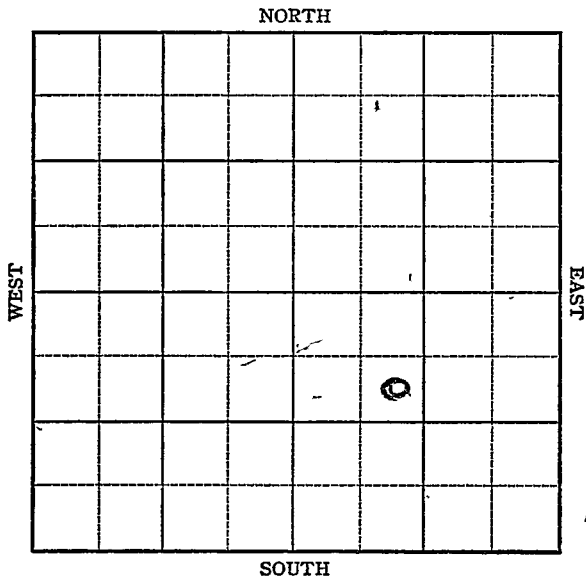



Sec. 32 Twp. 16 R. 13W

Well No. #7 Schriber Farm

Continental Company

Susank


990 Ft. from N. Line

_____ Ft. from S. Line

_____ Ft. from E. Line

990 Ft. from W. Line

SE NW SE

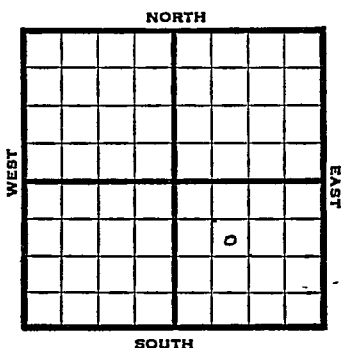

1947 Elev. 1899: REPORT

8/6 Location

8/13 RUR

8/20 10" @ 857'
Drlg. 2360'

8/27 3222 Fsg.

9/3 Quartzite 3305
TD 3311 6" @ 3310

9/10 Lansing 3083'
84 shots 3160-91 W & SO

9/17 Quartzite 3305'
6" @ 3310'
Lans. 3083'
Perf Lans. 2000 Acid
Pump 1050 oil & 27 W Pot
Gr. 38°
Total Depth 3450'

COMPLETED

Map No. _____ Sec. 32 Twp. 16 R. 13W

Well No. 7 Schriber

Continental Company

FIRST REPORT

Contractor

SE NW SE

SECTION PLAT

990 Ft. from N. Line

_____ Ft. from S. Line

_____ Ft. from E. Line

990 Ft. from W. Line

Barton County

Location _____ X

Rig up _____

Drilling and Remarks:

RECORD

Cased _____ in., _____ ft.

Sand _____

Gas _____

Oil _____

Total Depth _____

PRODUCTION

1st 24 hrs. Nat. _____

1st 24 hrs. after shot _____

Gas _____ Cu. Ft.

Dry Hole _____

Abandoned _____

Date

AUG 6 1947 19

S. J. LEWIS Scout

