

KANSAS


FORM 51 5M PETROL

Barton

Section 53 Township 16 Range 13-W

Well No. #4 ~~#5~~ Ainsworth

Company Black-Marshall

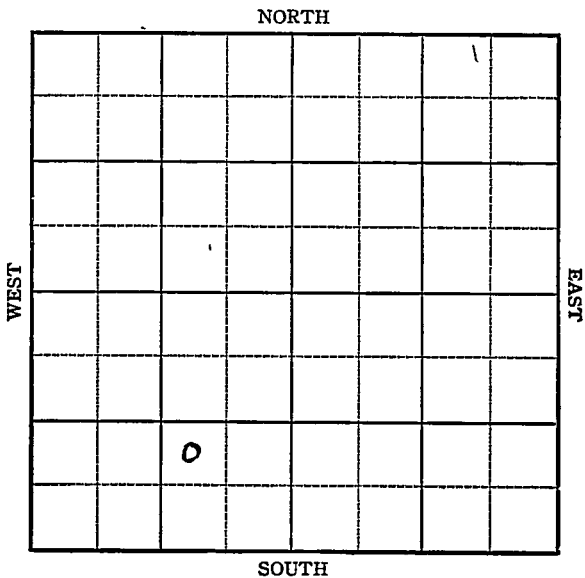

KANSAS

Map No. 73 Sec. 33 Twp. 16 R. 13WWell No. 5 AinsworthBlack-Marshall

Company

FIRST REPORT

Contractor

NW SE SW

 Ft. from N. Line990 Ft. from S. Line990 Ft. from E. Line Ft. from W. Line

Ainsworth Pool

SECTION PLAT

		1	
	0		

Location Rig up

Drilling and Remarks:

Surface Hole

RECORD

Cased in., ft.Sand Gas Oil Total Depth

PRODUCTION

1st 24 hrs. Nat. 1st 24 hrs. after shot Gas Cu. Ft.Dry Hole Abandoned

Date

AUG 25 1943

19

S. J. LEWIS

Scout

Barton

KANSAS
 Map No. 73 Sec. 33 Twp. 16 R. 13W

Well No. 4 Ainsworth

Black-Marshall Company

CORRECTION

Contractor

NW SE SW

SECTION FLAT

990 Ft. from N. Line

990 Ft. from S. Line

990 Ft. from E. Line

990 Ft. from W. Line

	o		

Ainsworth

Location

Rig up

Drilling and Remarks:

Change number
 was #5

RECORD

Cased in., ft.

Sand

Gas

Oil

Total Depth

PRODUCTION

1st 24 hrs. Nat.

1st 24 hrs. after shot

Gas Cu. Ft.

Dry Hole

Abandoned

Date

SEP 1 1943 19

S. J. LEWIS

Scout

KANSAS

Map No. 73 Sec. 33 Twp. 16 R. 13WWell No. 4 AinsworthBlack-Marshall

Company

COMPLETED

Contractor

NW SE SW

SECTION PLAT

	0		

Ft. from N. Line

990 Ft. from S. Line990 Ft. from E. Line

Ft. from W. Line

Ainsworth Pool

Location

Rig up

Drilling and Remarks:

*CE 3401**4" @ 3399**1000 acid**Sept. 15 1514 oil**4649 Water.**36 @*

RECORD

Cased _____ in., _____ ft.

Sand _____

Gas _____

Oil _____

Total Depth 3406

PRODUCTION

1st 24 hrs. Nat. _____

1st 24 hrs. after shot _____

Gas _____ Cu. Ft.

Dry Hole _____

Abandoned _____

Date

OCT 20 1943

19

S. J. LEWIS

Scout