


# Barton KANSAS

Section **33** Township **16** Range **13W**

Well Number **#3 Ainsworth**

Company **Armer & Vernon**

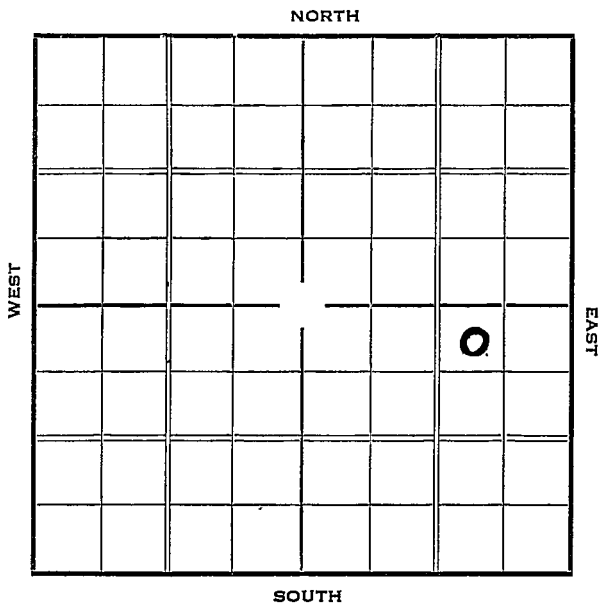

Sec. 33 Twp. 16 R. 13-W

Well No. #3 Ainsworth Farm


Armer & Vernon Company

330' Ft. from N. Line

         Ft. from S. Line

990' Ft. from E. Line

         Ft. from W. Line

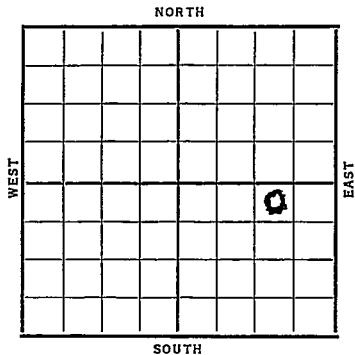

Date	REPORT
1937	
7/7	10" @ 253' WOC
7/16	Dr lg. 1735'.
7/23	Dr lg. 2987'.
7/30	Sil. 3376'. 5" @ 3375'.
	T.D. 3379'. RUST.
8/6	T.D. 3386'. 2900' oil. Pump 25 bbls. per hour. 1000 acid.
8/11	5" @ 3375'.
	Sil. 3376'.
	T.D. 3386'.
	1000 acid.
	T.D. 1737 bbls.
	COMPLETED

Barton KANSAS

Map No. \_\_\_\_\_ Sec. 33 Twp. 16 R. 13 WWell No. 3 - AinsworthArmer & Vernon Company

Contractor

## FIRST REPORT

## SECTION PLAT

330 Ft. from N. Line

\_\_\_\_\_ Ft. from S. Line

990 Ft. from E. Line

\_\_\_\_\_ Ft. from W. Line

			0

Location \_\_\_\_\_

Rig up \_\_\_\_\_

Drilling and Remarks:

10" - 253 woc

## RECORD

Cased \_\_\_\_\_ in., \_\_\_\_\_ ft.

Sand \_\_\_\_\_

Gas \_\_\_\_\_

Oil \_\_\_\_\_

Total Depth \_\_\_\_\_

## PRODUCTION

1st 24 hrs. Nat. \_\_\_\_\_

1st 24 hrs. after shot \_\_\_\_\_

Gas \_\_\_\_\_ Cu. Ft.

Dry Hole \_\_\_\_\_

Abandoned \_\_\_\_\_

Date

JUL 7 1937 19H. D. Hatfield

Scout

Barton KANSAS

Map No. \_\_\_\_\_ Sec. 33 Twp. 16 R. 13<sup>w</sup>Well No. 3-AinsworthArmer & Vernon Company

Contractor

**COMPLETED**330 Ft. from N. Line

\_\_\_\_\_ Ft. from S. Line

290 Ft. from E. Line

\_\_\_\_\_ Ft. from W. Line

**SECTION PLAT**

			0

Location \_\_\_\_\_

Rig up \_\_\_\_\_

Drilling and Remarks:

1000 acidPot - 1737**RECORD**Cased 5 in., 3375 ft.Sand 511 3376

Gas \_\_\_\_\_

Oil \_\_\_\_\_

Total Depth 3386**PRODUCTION**

1st 24 hrs. - Nat. \_\_\_\_\_

1st 24 hrs. after shot \_\_\_\_\_

Gas \_\_\_\_\_ Cu. Ft.

Dry Hole \_\_\_\_\_

Abandoned \_\_\_\_\_

Date

AUG 11 1937

H. D. Hatfield

19

Scout