


Section 31 Township 16 Range 3W

Well No. #1 Holmquist

Company Atlantic

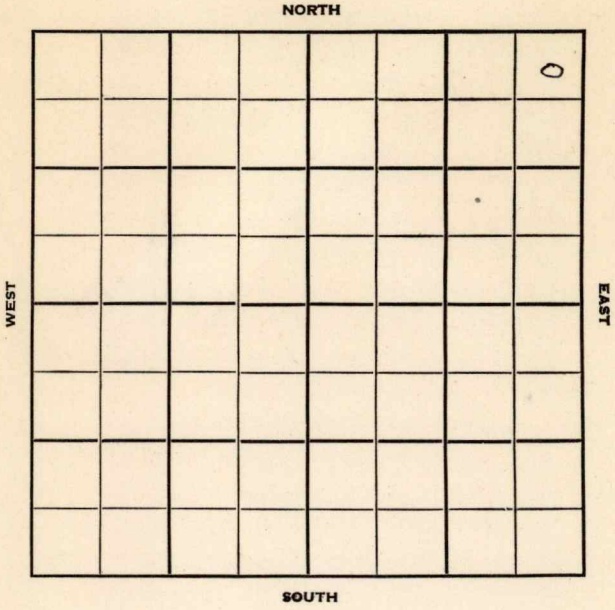

Saline

Sec. 31 Twp. 16 R. 3W

Well No. #1 Holmquist Farm

Atlantic Company

Contractor

Holm


330 Ft. from N. Line

\_\_\_\_\_ Ft. from S. Line

330 Ft. from E. Line

\_\_\_\_\_ Ft. from W. Line

NE NE NE

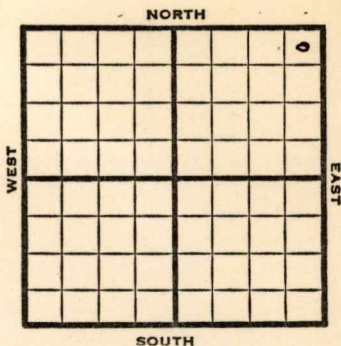

1952 **Elev. 1367'** REPORT

1/23 Spud 1-19-52  
8" @ 372'  
Drilg. 1550'

2/6 TD 3437  
5" @ 1427 POP

2/13 No report

2/20 "

2/27 Spud 1-19-52  
Oil Well T 3437  
8" @ 372'  
Heeb. 2078                      Lans. 2301  
Miss. 2949                      Kh. 3183  
Misener 3378  
TD 3429 5" @ 3427 S/ 25 boph  
8 hr. DD 3437 S/ 1 boph  
3000 A S/ 3 boph  
Comp. 58 bopd 2% wtr.

**COMPLETED**



County Saline State Kansas

Sec. 31 (Blk. Twp.) 16 (Sur. Rge.) 3W Map No.

Operator Atlantic

Well No. 1 Farm Holmquist

Elev. 1367 Location NE NE NE


330 Ft. From N Line NE  
330 Ft. From E Line Quarter

Ist. Report  
 Completion FEB 27 1952  
 Remarks Holm Pool intr.

Spudding Date 1-19-52

Drlg. Data Oil well TD 3437

8" @ 372 Heeb. 2078 Lans. 2301

Miss. 2949 Kh. 3183 Misener 3378

TD 3429 5" @ 3427 S/ 25 goph 8 hr.

DD 3437 S/ 1 boph 3000 A S/ 3 boph

Comp. 58 bopd 2% water

J. G. McGEHEE