


Section 32 Township 16 Range 3W

Well No. #2 Holm

Company Musfrove & Bay

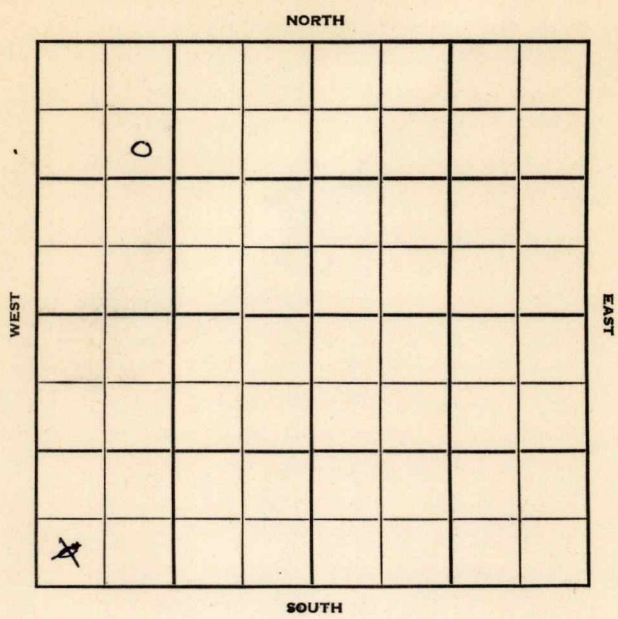

Sec. 32 Twp. 16 R. 3W ✓

Well No. #2 Holm Farm

Musgrove & Bay Company

Holm Contractor


990 Ft. from N. Line

 Ft. from S. Line

 Ft. from E. Line

990 Ft. from W. Line

SE NW NW

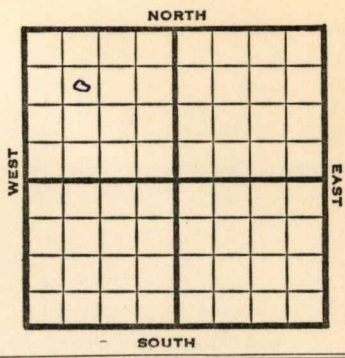

1952 **Elev. 1356'** REPORT

1/30	Location
2/6	C&P
2/13	No report
2/20	"
3/5	"
3/11	"
3/19	"
3/25	"
4/1	8" @ 372' Drlg. 1012'
4/9	Miss 2935 Drlg. 3085'
4/23	Mq. 3387' RTD 3389' 4" @ 3388'
4/30	CO DD 3391' 5 gal oil DD 3397 1000 A S/ 2 boph for 8 hrs. 2000 A S/ 2 boph DD 3408 TD tub. & rods.
5/7	NR
5/14	POP
5/21	NR
5/29	"
6/4	Spud 3-28-52 Oil Well TD 3408 8" @ 372 Miss 2935 Maq. 3387 TD 3389 4" @ 3388 DD 3391 5 go DD 3397 1000 A S/2 boph 2000 A S/2 boph DD 3408 Comp. 96 bopd

COMPLETED

County Saline State Kansas
 Sec. 32 (Blk. 16 (Sur. 3W Map No.
 (Twp.) (Rge.)
 Operator Musgrove & Bay
 Well No. 2 Farm Holm
 Elev. 1356 Location SE NW NW



990 Ft. From N Line NW

990 Ft. From W Line Quarter

1st. Report

Completion JUN 4 1952

Remarks Holm Pool

Spudding Date 3-28-52

Drlg. Data Oil well TD 3408

8" @ 372 Miss. 2935 Maq. 3387

TD 3389 4" @ 3388 DD 3391 5 go

DD 3397 1000 A S/ 2 boph 2000 A

S/ 2 boph DD 3408 Comp. 96 bopd

J. G. McGEHEE