

KANSAS


FORM 51 5M 1-42 PETROL

Barton

Section 33 Township 16 Range 13-W

Well No. #7 Ainsworth

Company Black-Marshall

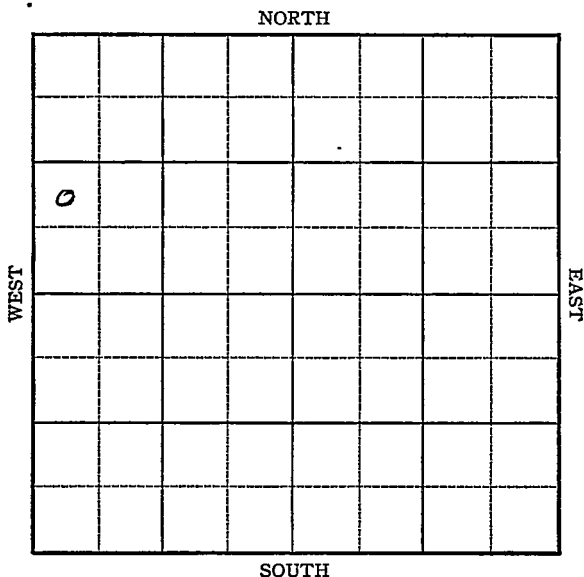


Sec. 33 Twp. 16 R. 13-N

Well No. #7 Ainsworth Farm

Black-Marshall Company

NORTH

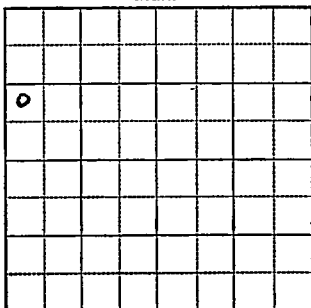

SOUTH

_____ Ft. from N. Line

990 Ft. from S. Line

_____ Ft. from E. Line

330 Ft. from W. Line

Elev. 1941

1943

R E P O R T

9/29 Location

10/6 8" @ 187
Drlg. 1450'

10/13 Lans 3159
Drlg. 3261

10/20 Arb 3394-95 $\frac{1}{2}$ T.D.
5" @ 3394
Rust

10/27 "

11/3 T.D. 3432 SW To Perf.

11/10 36 shots 3165-77 $\frac{1}{2}$
36 shots 3376-96 $\frac{1}{2}$
No oil

11/17 " " "

11/24 TD 3584

12/8 Drlg. 3743

12-15 TD 3831' in sand
PB 3562'

12/22 PB 3585
238' of 4" liner @ 3563
WOC.

12-29 TD 3831'
Arb. 3394'
5" at 3394'
238' of 4" liner At 3563'
SWD

'ABANDONED

KANSAS
 Map No. 73 Sec. 33 Twp. 16 R. 13W

Well No. 7 Ainsworth

Black-Marshall Company

FIRST REPORT Contractor

NW SW NW

SECTION PLAT

 Ft. from N. Line

990 Ft. from S. Line

 Ft. from E. Line

330 Ft. from W. Line

o			

Ainsworth Pool

Location X

Rig up

Drilling and Remarks:

RECORD

Cased in., ft.

Sand

Gas

Oil

Total Depth

PRODUCTION

1st 24 hrs. Nat.

1st 24 hrs. after shot

Gas Cu. Ft.

Dry Hole

Abandoned

Date

SEP 29 1943

19

S. J. LEWIS

Scout

