

KANSAS


Barton

FORM 51 5M PETROL

Section 33 Township 16 Range 13-W

Well No. #8 Ainsworth

Company Black Marshall

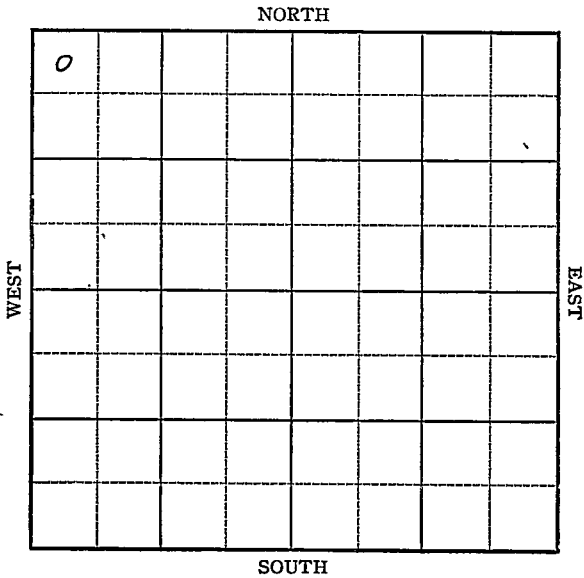

Sec. 33 Twp. 16 R. 13-W

Well No. #8 Ainsworth Farm

Black-Marshall Company


330 Ft. from N. Line

 Ft. from S. Line

 Ft. from E. Line

330 Ft. from W. Line

Elev. 1932

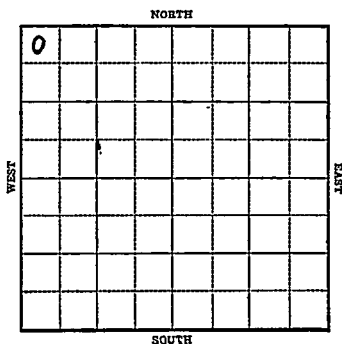

1943

R E P O R T

10/20 8" @ 187'
W.O.C.

10/27 Anhy 865
Drlg. 3150'

11/3 Lans 3148
Arb 3383
T.D. 3386'
5" @ 3382
Rust

11/10 T.D. ~~3389~~-2300' oil in 16 hrs.

11/17 Pump Pump Pot. 182

11/24 5" @ 3382'
Arb. 3383'
Pump 182 Pot.
Gravity 36°
TD 3389'

COMPLETED

KANSAS

Map No. 73 Sec. 33 Twp. 16 R. 13W

Well No. 8 Ainsworth

Black-Marshall Company

FIRST REPORT

Contractor

NW/C

SECTION PLAT

330 Ft. from N. Line

o			

_____ Ft. from S. Line

_____ Ft. from E. Line

330 Ft. from W. Line

Ainsworth Pool

Location _____

RECORD

Rig up _____

Cased _____ in., _____ ft.

Drilling and Remarks:

Sand _____

Gas _____

Oil _____

8" - 187 WOC

Total Depth _____

PRODUCTION

1st 24 hrs. Nat. _____

1st 24 hrs. after shot _____

Gas _____ Cu. Ft.

Dry Hole _____

Abandoned _____

Date

OCT 20 1943 19

S. J. LEWIS Scout

KANSAS

Map No. 79 Sec. 33 Twp. 16 R. 13W

Well No. 8 Ainsworth

Black-Marshall Company

COMPLETED

Contractor

NW/C

SECTION PLAT

330 Ft. from N. Line

_____ Ft. from S. Line

_____ Ft. from E. Line

330 Ft. from W. Line

o			

Ainsworth Pool

RECORD

Location _____

Cased _____ in., _____ ft.

Rig up _____

Sand _____

Drilling and Remarks:

Gas _____

Oil _____

Total Depth 3389

Cr & 3383

5" @ 3382

Pump 182 Bx.

PRODUCTION

1st 24 hrs. Nat. _____

1st 24 hrs. after shot _____

Gas _____ Cu. Ft.

Dry Hole _____

Abandoned _____

36° Se

Date

NOV 24 1943