Saline


DX 78-1

KANSAS

Section 32 Township 16 Range 3W

Well No. #1 ~~Holmgren~~ Gibson

Company DeWeese & ~~Sanderson~~

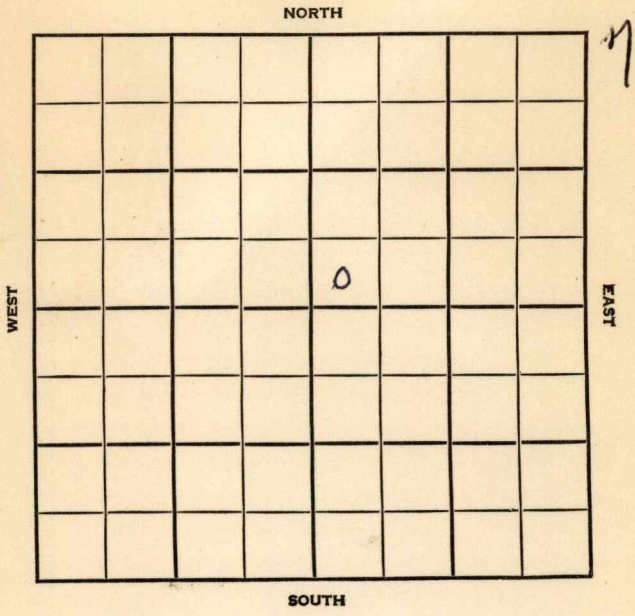

Saline KANSAS

SEC.	TWP.	R.
32	16	3W

WELL NO. #1 ~~Holmgren~~ Gibson FARM

COMPANY

DeWeese & Sanderson

CONTRACTOR

Melland

Holm Pool


_____ Ft. from N. Line

330 Ft. from S. Line

_____ Ft. from E. Line

330 Ft. from W. Line

SW SW NE

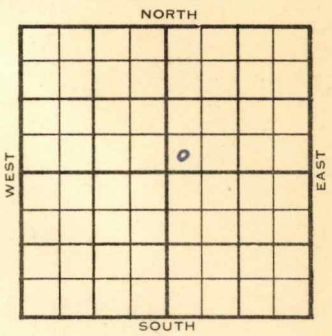

1954	ELEVATION 1369' REPORT
5/5	Spud 4-29-54 8" @ 355' Drlg 1658'
5/12	Miss. 2931 Kh 3165 Mq. 3337'
5/19	RTD 3398' 5" @ 3394
5/26	Spud 4-29-54 Oil Well TD 3398' 8" @ 355' Miss 2931', Kh. 3165', Maq. 3337' TD 3398' 5" @ 3394' CO to 3398' FU 500' fluid 30% wtr 14 hrs. 1000A S/15 bopd 30% wtr. Comp. 10 bopd 30% wtr.

COMPLETED

DX-78

FORM 275 FOR SALE BY KANSAS BLUE PRINT CO.


County Saline State Kansas

Sec. 32 (Blk. Twp.) 16 (Sur. Rge.) 3W Map No.

Operator DeWeese & Sanderson

Well No. 1 Farm Holmgren

Elev. Location SW SW NE

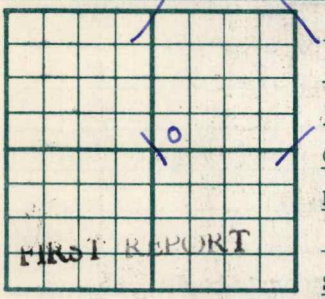

330 Ft. From S Line NE

330 Ft. From W Line Quarter

1st. Report MAY 5 1954

Completion

Remarks Melland - Contr.

Spudding Date 4-29-54

Drlg. Data Holm Pool

8" @ 355 drlg. 1658

J. G. McGEHEE

FORM 26 PETROL
200 BKS. 7-51

Kansas

Map No. _____ Sec. 32 Twp. 16 R. 3W


Well No. 1 Gibson

DeWeese & Sanderson Company

CORRECTION Contractor

SW SW NE

SECTION PLAT

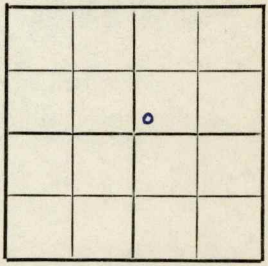

_____ Ft. from N. Line

330 Ft. from S. Line

_____ Ft. from E. Line

330 Ft. from W. Line

Saline County

Location _____

Rig up _____

Drilling and Remarks:

Reported
#1 Holmgren

RECORD

Cased _____ in., _____ ft.

Sand _____

Gas _____

Oil _____

Total Depth _____

PRODUCTION

1st 24 hrs. Nat. _____

1st 24 hrs. after shot _____

Gas _____ Cu. Ft.

Dry Hole _____

Abandoned _____

Date

_____ 19 _____

_____ Scout

FORM 275 FOR SALE BY KANSAS BLUE PRINT CO.

County Saline State Kansas

Sec. 32 (Blk. Twp.) 16 (Sur. Rge.) 3W Map No.

Operator DeWeese & Sanderson

Well No. 1 Farm Gibson

Elev. 1369 Location SW SW NE



330 Ft. From S Line NE

330 Ft. From W Line Quarter

1st. Report

Completion MAY 26 1954

Remarks Holm Pool

Melland - Contr.

Spudding Date 4-29-54

Drlg. Data Oil well TD 3398

8" @ 355 Miss. 2931 Kh. 3165

Maq. 3337 TD 3398 5" @ 3394 CO to 3398

FU 500' fluid 30% wtr. 14 hr. 1000 A

S/ 15 bopd 30% wtr.

Comp. 10 bopd 30% wtr.

J. G. McGEHEE