



Sec. 33 Twp. 16 R. 13W

Well No. #10 Ainsworth Farm

Black-Marshall Company


Susank

\_\_\_\_\_ Ft. from N. Line

330 \_\_\_\_\_ Ft. from S. Line

330 \_\_\_\_\_ Ft. from E. Line

\_\_\_\_\_ Ft. from W. Line

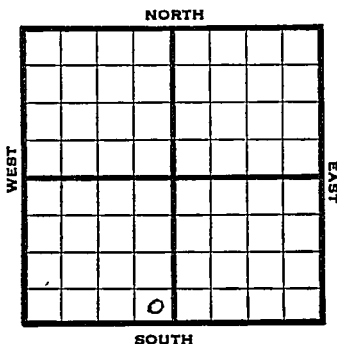

SE SW

1945 Elev. 1955 REPORT

12/28 8" @ 247  
Drlg. 855'

1946  
1/10 Anhy 810' Lans. 3172'  
Arb. 3404-10' T.D. S.O.  
5" - 3406' RUST.

1/17 " " "  
1/24 T.D. 3410' 500 acid.  
Pump 27 oil per hour.

1/30 Arb. 3406  
5" @ 3406  
500 acid.  
TD 3410'  
Depth Pot. 2620  
Grav. 34.7

**COMPLETED**



KANSAS

Kansas Pool Name SusankMap No. 73 Sec. 33 Twp. 16 R. 13WWell No. 10 AinsworthBlack, Marshall

Company

COMPLETED

Contractor

SE SW

E 1, 1955  
SECTION PLAT       Ft. from N. Line330 Ft. from S. Line330 Ft. from E. Line       Ft. from W. Line


Barton CountyLocation       Rig up       

Drilling and Remarks:

Art 34065" @ 8406500 acidDepth Pad 2620342 ge

## RECORD

Cased        in.,        ft.Sand       Gas       Oil       Total Depth 3410

## PRODUCTION

1st 24 hrs. Nat.       1st 24 hrs. after shot       Gas        Cu. Ft.Dry Hole       Abandoned       Date       JAN 30 1946 19S. J. LEWIS

Scout