

KANSAS

Barton

FORM 51 IOM 12-46 PETROL

Section 33 Township 16 Range 13WWell No. 12 AinsworthCompany Black-Marshall

0							

Susank NORTH

WEST EAST

SOUTH

KANSAS

Barton

Sec. 33 Twp. 16S R. 13W

Well No. 12 Ainsworth Farm

Black-Marshall Company


Susank Pool

 Ft. from N. Line

330 Ft. from S. Line

 Ft. from E. Line

330 Ft. from W. Line

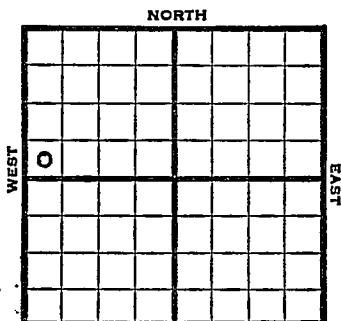

SW NW

Elev. 1943'

SOUTH

1947

REPORT

3/26

8" @ 240'
Anhy 875'
Drlg. 2030'

4/2

Lansing 3147'
Arbuckle 3893'-97' TD
5" @ 3395'
RUST

4/9

TD 3401'
Swb 12 bbls oil PH

4/15

" "

4/23

Arb 3393
5" @ 3395
Pump 205 Pot
Grav. 37
TD 3401'

COMPLETED

Map No. 1573 Sec. 33 Twp. 16 R. 13W ^{14S}

Well No. 12 Ainsworth

Black-Marshall Company

FIRST REPORT

Contractor

SW NW


SECTION PLAT

 Ft. from N. Line

330 Ft. from S. Line

 Ft. from E. Line

330 Ft. from W. Line

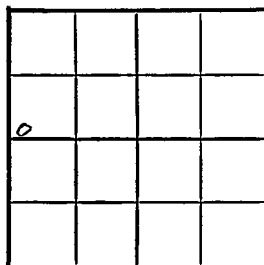

Barton County

Location

Rig up

Drilling and Remarks:

8" @ 240

anhy 875

drlg. 2030

RECORD

Cased in., ft.

Sand

Gas

Oil

Total Depth

PRODUCTION

1st 24 hrs. Nat.

1st 24 hrs. after shot

Gas Cu. Ft.

Dry Hole

Abandoned

Date

MAR 26 1947 19

S. J. LEWIS Scout

Kansas


KANSAS

Map No. K 73 Sec. 33 Twp. 16 R. 13WWell No. 12 AinsworthBlack-Marshall Company

COMPLETE

Contractor

SW NW

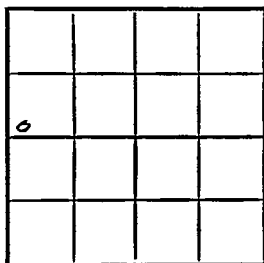E 11943
SECTION PLAT Ft. from N. Line330 Ft. from S. Line Ft. from E. Line330 Ft. from W. Line

Barton County

Location Rig up

Drilling and Remarks:


RECORD

Cased in. ft.Sand Gas Oil Total Depth 3401

PRODUCTION

1st 24 hrs. Net 1st 24 hrs. after shot Gas Cu. Ft.Dry Hole Abandoned

Date

APR 23 1947

19

S. I. LEWIS

Scout