


Section 33 Township 16 Range 13-W

Well No. 4 - Ainsworth "A"


Company Continental

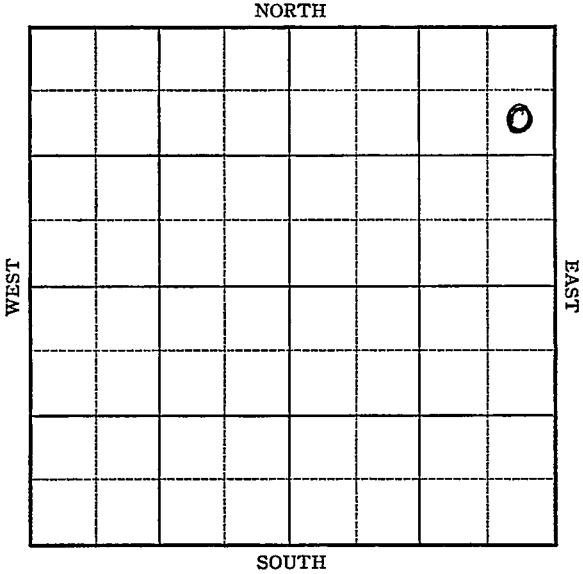

Sec. 33 Twp. 16 R. 13-W

Well No. #4 Ainsworth "A" Farm
Continental Company

990 Ft. from N. Line
 _____ Ft. from S. Line
330 Ft. from E. Line
 _____ Ft. from W. Line
 Elev. 1938

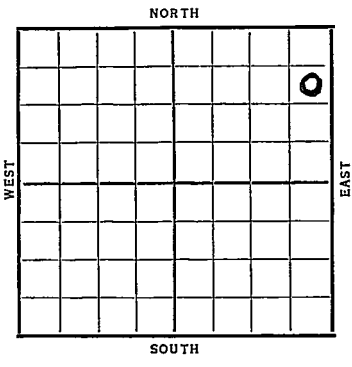

Date	REPORT
1937	
6/9	B. J. R. R.
6/19	10" @ 347'. WOC.
6/25	Drlg. 2420'.
7/2	Drlg. 3320'.
7/9	Sil. 3397'. 7" @ 3398'.
	T.D. 3399'.
7/16	T.D. 3402'. 3000' oil 24 hrs.
7/21	Sil 3397'
	7" @ 3398'
	TD 3402'
	Pot 1364'
	COMPLETED

Barton **KANSAS**

Map No. 73 Sec. 33 Twp. 16 R. 13^W

Well No. 4 - Ainsworth "A"

Continental Company

Contractor

FIRST REPORT

SECTION PLAT

990 Ft. from N. Line

 Ft. from S. Line

330 Ft. from E. Line

 Ft. from W. Line

				0

Location _____

Rig up _____

Drilling and Remarks:

BRR

RECORD

Cased _____ in., _____ ft.

Sand _____

Gas _____

Oil _____

Total Depth _____

PRODUCTION

1st 24 hrs. Nat. _____

1st 24 hrs. after shot _____

Gas _____ Cu. Ft.

Dry Hole _____

Abandoned _____

Date

JUN 9 1937 19

H. D. Hatfield

Scout

*Barton*Map No. 73 Sec. 33 Twp. 16 R. 13 WWell No. 4 - Ainsworth "A"Continental Company

Contractor

COMPLETED**SECTION PLAT**990 Ft. from N. Line

_____ Ft. from S. Line

330 Ft. from E. Line

_____ Ft. from W. Line

			0

Location _____

Rig up _____

Drilling and Remarks:

*Pat - 1364***RECORD**Cased 7 in., 3398 ft.Sand Si 3397

Gas _____

Oil _____

Total Depth 3402**PRODUCTION**

1st 24 hrs. Nat. _____

1st 24 hrs. after shot _____

Gas _____ Cu. Ft.

Dry Hole _____

Abandoned _____

Date

JUL 21 1937 19 H. D. Hatfield Scout