


Section 32 Township 16 Range 3W

Well No. 1 Nelson

Company DeWeese & Sanderson

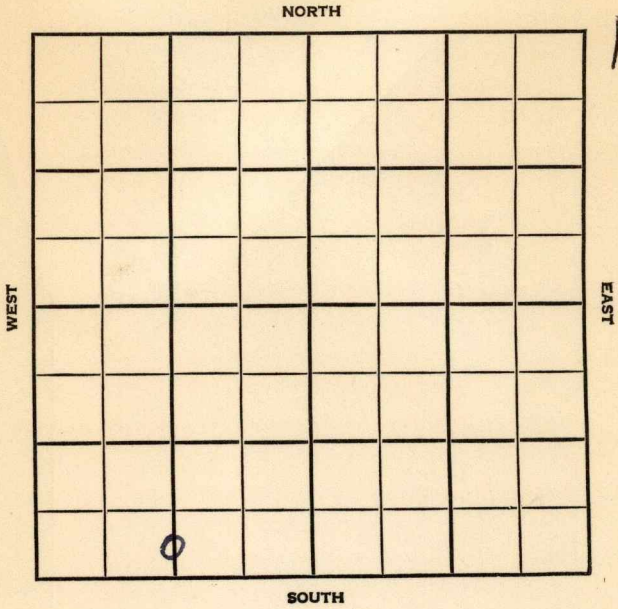

Saline

KANSAS

SEC.	TWP.	R.
32	16	3 W

WELL NO.

1 Nelson

FARM

COMPANY

DeWeese & Sanderson

CONTRACTOR

Kaifer & Krause

Salemsberg Pool

Ft. from N. Line


330

Ft. from S. Line

Ft. from E. Line

1320

Ft. from W. Line

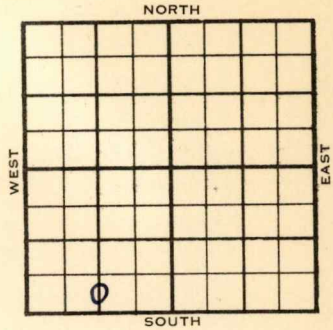C S $\frac{1}{2}$ S $\frac{1}{2}$ SW

ELEVATION

REPORT

1955

-

1/26

Spud 1-14-55

8" @ 340 Miss. 2913

DST 2974-79 open $\frac{1}{2}$ hr rec 25' SOCM

510# Maq. dol. 3373

TD 3379 5" @ 3374

2/16

Spud 1-14-55

Oil Well

TD 3379'

8" @ 340'

Miss 2913'

DST 2974'-79' opn $\frac{1}{2}$ hr, rec 25' SOCM

510# Maq. dolo. 3373'

TD 3379'

5" @ 3374'

CO to 2379 S/ 1 boph 1000 A

S/ 2 boph 6 hr.

Comp 25 bopd.

COMPLETED

