


Saline

Section 36 Township 16 Range 3W

Well No. #1 Holt

Company Bay Pet.

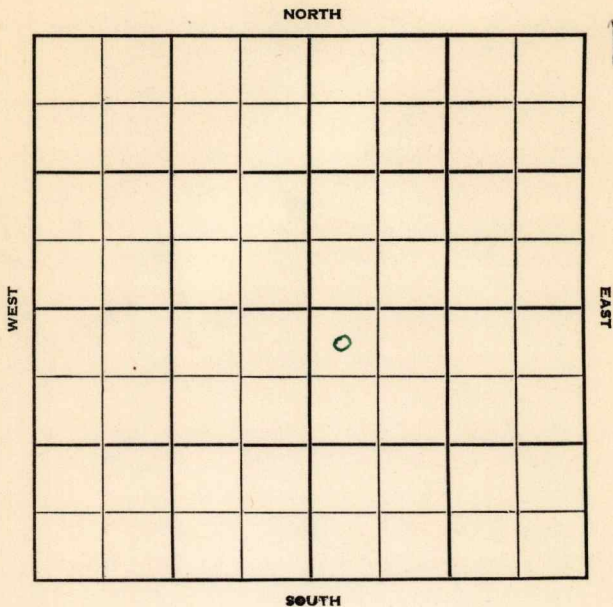

Saline

KANSAS

Sec. 36 Twp. 16 R. 3W

Well No. #1 Holt Farm

Bay Pet. Company

Lindsley Wildcat Contractor


330' Ft. from N. Line

_____ Ft. from S. Line

_____ Ft. from E. Line

330' Ft. from W. Line

NW NW SE

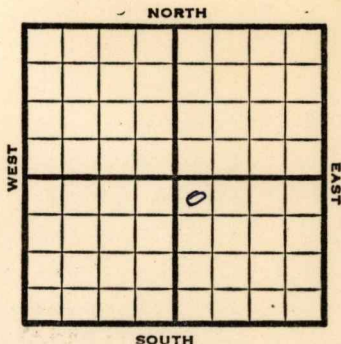

1951

Elev. -

REPORT


11/21

RUR

11/28

Abandoned Location

ABANDONED

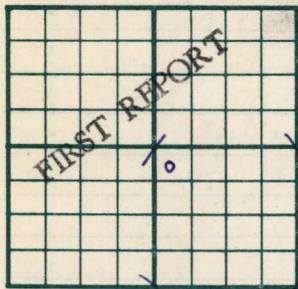County **Saline** State **Kansas**Sec. **36** (Blk. Twp.) **16** (Sur. Rge.) **3W** Map No.Operator **Bay Pet.**Well No. **1** Farm **Holt**Elev. Location **NW NW SE****330** Ft. From **N** Line **SE****330** Ft. From **W** Line **Quarter**1st. Report **NOV 21 1951**

Completion


Remarks

Lindsley - Contr.

Spudding Date

Drlg. Data **Wildecat****RUR**

J. E. TYRA

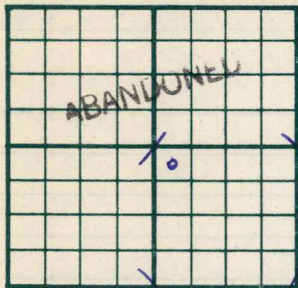County **Saline** State **Kansas**Sec. **36** (Blk.) **16** (Sur.) **3W** Map No.Operator **Bay Petroleum**Well No. **1** Farm **Holt**Elev. Location **NW NW SE****330** Ft. From **N** Line **SE****330** Ft. From **W** Line **Quarter**

1st. Report

Completion **NOV 28 1951**Remarks **Wilcat****Lindsley - Contr.**

Spudding Date

Drlg. Data

Abd. location