

Section 1 Township 16 Range 4W

Well No. #1 Olsson

Company Eldorado Refg.

NORTH

2							

SOUTH

WEST

EAST

12

Saline

KANSAS

Sec. 1 Twp. 16 R. 4W

Well No. #1 Olsson Farm

Eldorado Ref. Company

Sterling Drlg. - Contr. Contractor

Ryding Pool


330' Ft. from N. Line

Ft. from S. Line

Ft. from E. Line

330' Ft. from W. Line

NW NW SW

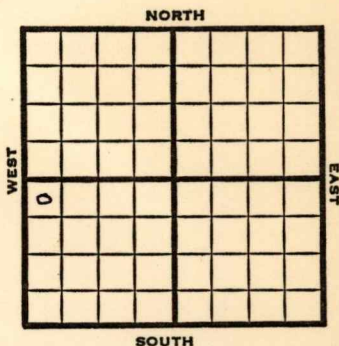

1951

Elev. 1314'


REPORT

5/16 Spud 5-12-51
8" @ 320
Drlg. 375'

7/3 Spud 5-12-51
Oil well TD 3427' 8" @ 320'
Miss. 2911' Kh. 3204' Hunton 3346'
Maq. dol. 3422'
DST 3423-26' open $\frac{1}{2}$ hr. rec 540' oil,
120' OCM
5 $\frac{1}{2}$ " @ 3422 TD 3427' FU 2450' oil
4 hr. S/16 BOPH
Comp. 528 BOPD

COMPLETED

County Saline State Kansas
 Sec. 1 (Blk.) 16 (Sur.) 4W Map No.
 Operator ElDorado Ref.
 Well No. 1 Farm Olsson
 Elev. Location NW NW SW

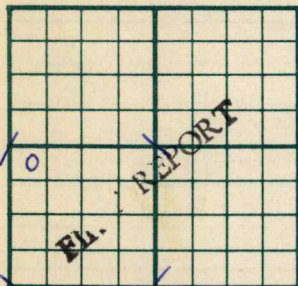

330 Ft. From N Line SW
330 Ft. From W Line Quarter
 1st. Report MAY 16 1951

Completion

Remarks Derby IHM

Sterling Drlg. - Contr.


Spudding Date 5-12-51

Drlg. Data Ryding Pool

8" @ 320 drlg. 375

J. E. TYRA

County Saline State Kansas
 Sec. 1 (Blk.) 16 (Sur.) 4W Map No.
 (Twp.)
 Operator Eldorado Ref.
 Well No. 1 Farm Olsson
 Elev. 1314 Location NW NW SW

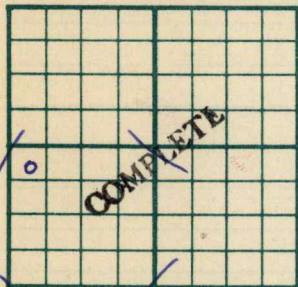

330 Ft. From N Line SW
330 Ft. From W Line Quarter

1st. Report JUL 3 1951

Completion

Remarks Ryding Pool

Sterling Drlg. - Contr.

Spudding Date 5-12-51

Drlg. Data Oil well TD 3427

8" @ 320 Miss. 2911 Kh. 3204

Hunton 3346 Maq. dol. 3422 DST 3423-26

open $\frac{1}{2}$ hr. Rec. 540' oil 120' ocm

5 $\frac{1}{2}$ " @ 3422 TD 3427 FU 2450' oil 4 hr.

S/ 16 boph Comp. 528 bopd

J. E. TYRA