


Section 1 Township 16 Range 14W

Well No. #1 Palm

Company Seymour & Phillips

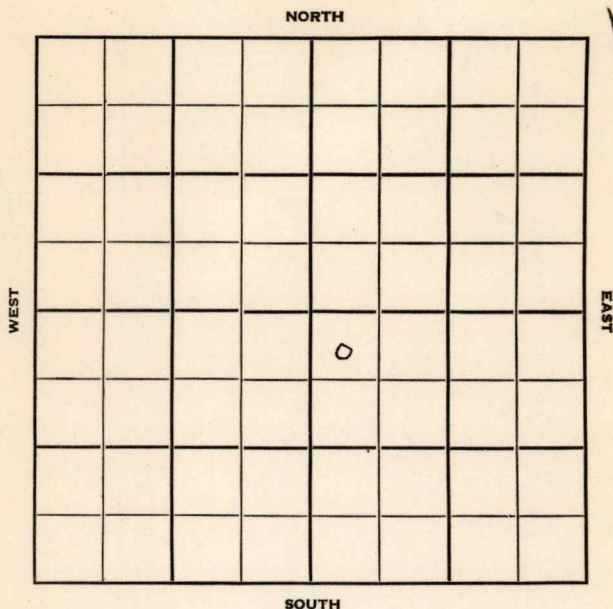

Saline

KANSAS

Sec. 1 Twp. 16 R. 4 W ✓

Well No. # 1 Palm Farm

Seymour & Phillips Company

Melland Drlg. Contractor

Smolan Pool


330 Ft. from N. Line

_____ Ft. from S. Line

_____ Ft. from E. Line

330 Ft. from W. Line

NW NW SE

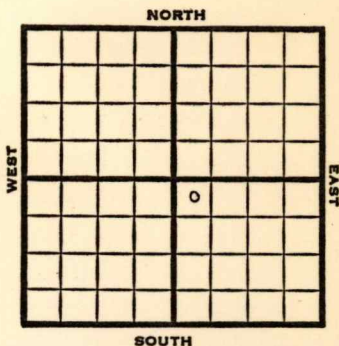


1951 **Elev. 1307'** REPORT

8/29 Spud 8-25-51
8" @ 350' WOC

9/12 Spud 8-25-51
D & A TD 3440' 8" @ 350
Burgess 2905' Miss 2907' Kh. 3210
Misener he. 3337' Maq. sh. 3365'
Hunton sh. 3367' Maq. dol. 3436'
DST 3437-40' open 45 min. rec 393' mud
& SW TD 3440' D & A

ABANDONED

County **Saline** State **Kansas**
 Sec. **1** (Blk.) **16** (Sur.) **4W** Map No.
 Operator **Seymour & Phillips**
 Well No. **1** Farm **Palm**
 Elev. Location **NW NW SE**

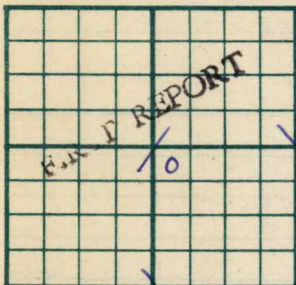

330 Ft. From **N** Line **SE**
330 Ft. From **W** Line Quarter

1st. Report **AUG 29 1951**

Completion

Remarks

Melland Drlg. - Contr.

Spudding Date **8-25-51**

Drlg. Data **Smolan Pool**

8" @ 350 WOC

J. E. TYRA

County Saline State Kansas
 Sec. 1 (Blk.) 16 (Sur.) 4W Map No.
 Operator Seymour & Phillips
 Well No. 1 Farm Palm
 Elev. 1307 Location NW NW SE

330' Ft. From N Line SE330' Ft. From W Line Quarter

1st. Report

Completion SEP 12 1951Remarks Smolan PoolMelland Drlg. - Contr.Spudding Date 8-25-51Drlg. Data D & A TD 34408" @ 350 Burgess 2905 Miss. 2907Kh. 3210 Misener he. 3337 Maq. sh. 3365Hunton sh. 3367 Maq. dol. 3436 DST 3437-40 open 45 min. Rec. 393' mud & SWTD 3440 D & A

J. E. TYRA