


Section 1 Township 16 Range 4 W

Well No. # 1 Ryding

Company T. A. Phillips & Sanderson

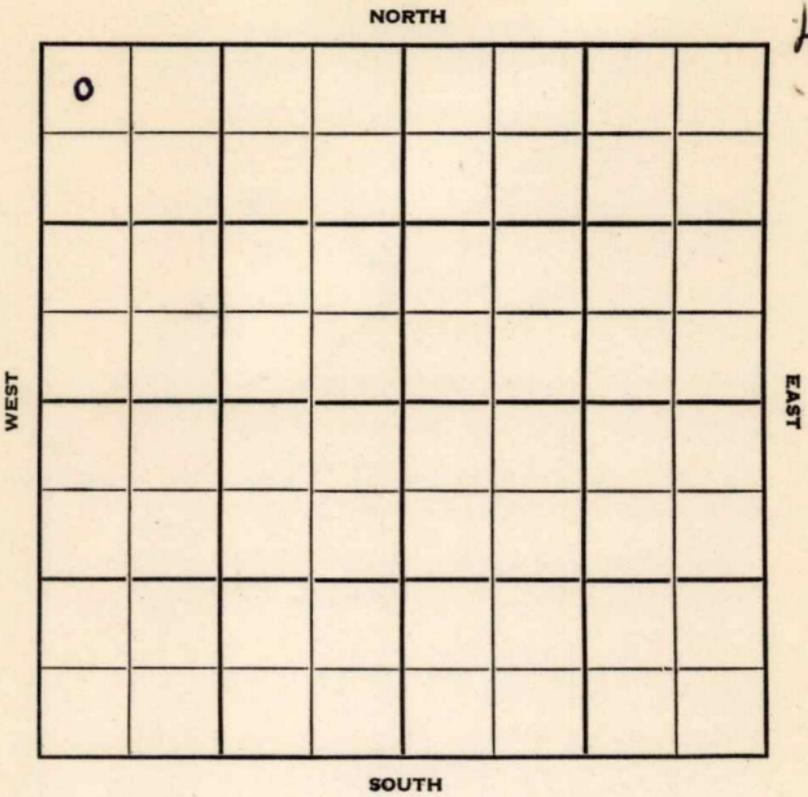

Saline

KANSAS

Sec. 1 Twp. 16 R. 4 W

Well No. # 1 Ryding Farm

T. A. Phillips & Sanderson Company

Sterling Drlg. Contractor

Wildcat

330 Ft. from N. Line


Ft. from S. Line

Ft. from E. Line

330 Ft. from W. Line

NW NW NW

Derby DHM

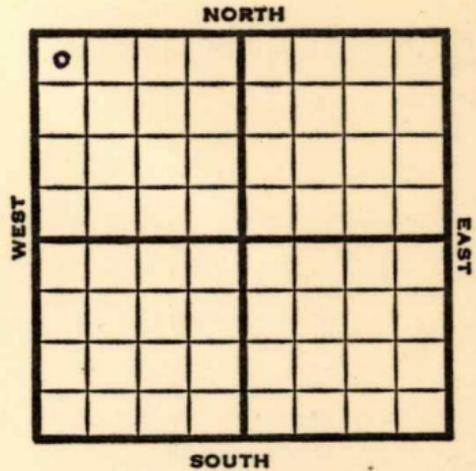

1951

Elev. 1324'

REPORT

3/7

Cellar & Pits

5/2

Spud 3-9-51

Oil well TD 3443' 8" @ 334

Lost circ. @ 1852' Skid rig 50' SE

13" @ 155 8" @ 355

Miss. 2916', Kinderhook 3200',

Misnor 3338', Hunton 3359',

Maq. 3367', Dol. 3439-43',

DST 3440-43 open 1/2 hr. rec 425' oil

4" @ 3439' TD 3443' S/15 BOPH

Comp. 508 BOPD

COMPLETED

County **Saline** State **Kansas**

Sec. **1** (Blk.) **16** (Sur.) **4W** Map No.

Operator **T. A. Phillips & Sanderson**

Well No. **1** Farm **Ryding**

Elev. Location **NW NW NW**

0					

330 Ft. From **N** Line **NW**

330 Ft. From **W** Line **Quarter**

Ist. Report **MAR 7 1951**

Completion

Remarks **Derby DHM**

Sterling Drlg. - Contr.

Spudding Date

Drlg. Data **Wildcat**

Cellar & pits

J. E. TYRA

County Saline State Kansas

Sec. 1 (Blk. Twp.) 16 (Sur. Rge.) 4W Map No.

Operator T. A. Phillips & Sanderson

Well No. 1 Farm Ryding

Elev. 1324 Location NW NW NW

0					

330 Ft. From N Line NW
330 Ft. From W Line Quarter

1st. Report

Completion MAY 2 1951

Remarks Wildcat

Sterling Drlg. - Contr.

Spudding Date 3-9-51

Drlg. Data Oil well TD 3443

8" @ 334 Lost circ. @ 1852 Skid rig

50' SE 13" @ 155 8" @ 355 Miss. 2916

Kinderhook 3200 Misenor 3338

Hunton 3359 Maq. 3367 Dol. 3439-43

DST 3440-43 open 1/2 hr. Rec. 425' oil

4" @ 3439 TD 3443 S/ 15 bopd

Comp. 508 bopd

J. E. TYRA