

Section 1 Township 16 Range 4WWell No. #2 OlssonCompany El Dorado

NORTH

13

SOUTH

WEST

EAST



Sec. 1 Twp. 16 R. 4W

Well No. #2 Olsson Farm

El Dorado Company

Sterling
Smolin Contractor


990 Ft. from N. Line

990 Ft. from S. Line

Ft. from E. Line

330 Ft. from W. Line

~~SW NW SW~~
NW SW SW

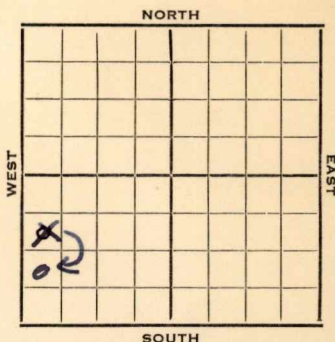


1952

Elev. 1313' REPORT

5/7 MIR
5/14 8" @ 363 Anhy 362
Drlg. 1655'
5/21 Miss 2916' Htn 3356' Mq Dol 3427'
RTD 3428' 5" @ 3427'
5/28 WOCT
6/12 DP 3428 Fill up 250' fluid 1 hr.
S/6 1/4 BF plus SSO 16/3424-27
3 1/2 BWPH
6/18 NR
6/25 NR
7/2 DD
7/9 NR
7/17 "
7/23 DD 3493' TD. D&A HOLD
7/30 Spud 5-7-52
D & A TD 3493' 8" @ 363
Anhy 362' Miss 2916' Hunton 3356'
Maq. 3427' TD 3428' 5" @ 3427
DP to 3428' FU 250' fluid 1 hr.
S/6 1/4 BF & SO 16/3424-27 3 1/2 BWPH
DD 3493' Kh. 3213' Maq. 3368'
D & A

ABANDONED

County **Saline** State **Kansas**
Sec. **1** (Blk.) **16** (Sur.) **4W** Map No.
Operator **El Dorado**
Well No. **2** Farm **Olsson**
Elev. Location **SW NW SW**

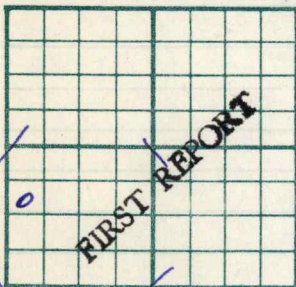

990 Ft. From **N** Line **SW**
330 Ft. From **W** Line Quarter

1st. Report **MAY 7 1952**

Completion

Remarks

Sterling - Contr.

Spudding Date

Drlg. Data

Smolin

MIR

J. G. McGEHEE

Map No. _____ Sec. 1 Twp. 16 R. 4WWell No. 2 Olsson

Eldorado Ref. _____ Company

~~CORRECTION~~ _____ Contractor

NW SW SW

SECTION PLAT

_____ Ft. from N. Line

990 Ft. from S. Line

_____ Ft. from E. Line

330 Ft. from W. Line

0			

Saline County

Location _____

Rig up _____

Drilling and Remarks:

Reported

SW NW SW

RECORD

Cased _____ in., _____ ft.

Sand _____

Gas _____

Oil _____

Total Depth _____

PRODUCTION

1st 24 hrs. Nat. _____

1st 24 hrs. after shot _____

Gas _____ Cu. Ft.

Dry Hole _____

Abandoned _____

Date

MAY 14 1952

19

J. G. McGEHEE

Scout

County Saline State Kansas
 Sec. 1 (Blk.) 16 (Sur.) 4W Map No.
 Operator ElDorado
 Well No. 2 Farm Ols son
 Elev. 1313 Location NW SW SW



990 Ft. From S Line SW
330 Ft. From W Line Quarter
 1st. Report

Completion JUL 30 1952

Remarks Smolan Pool
Sterling Drlg. - Contr.

Spudding Date 5-7-52

Drlg. Data D & A TD 3493

8" @ 363 Anhy362 Miss. 2916 Hunton3356

Maq. 3427 TD 3428 5" @ 3427 DP to 3428

FU 250' fluid 1 hr. S/ 6 $\frac{1}{4}$ bf & SO

16/ 3424-27 3 $\frac{1}{2}$ bwph DD 3493

Kh. 3213 Maq. 3368

D & A