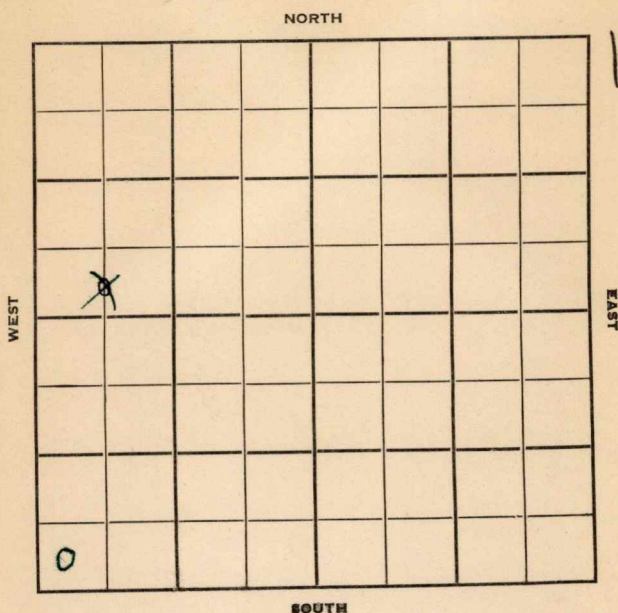


Section 1 Township 16 Range 4WWell No. #2 ~~#1~~ RydingCompany Phillips & Sanderson

Saline

KANSAS

Sec. 1 Twp. 16 R. 4 W

Well No. # 2 Ryding Farm

Phillips & Sanderson Company

Melland Drlg. Contractor

Smolan Pool


Ft. from N. Line

330 Ft. from S. Line

Ft. from E. Line

330
660 Ft. from W. Line

~~0 S L SW NW~~
SW SW SW

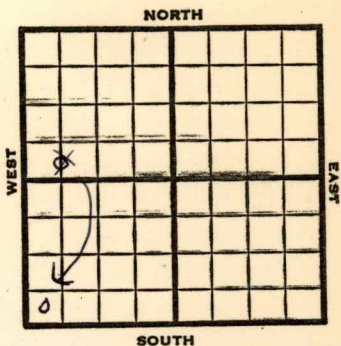

1951

Elev. 1313' REPORT

8/15

Spud 8-12-51
8" @ 350 WOC

10/24

Spud 8-12-51
Oil Well TD 3423
8" @ 350
Miss. 2911 Kh. 3202
Mag. sh. 3358 Mag. dol. 3421-23
5" @ 3421 TD 3423 1 BOPH
750 A S/ 5 BOPH
Comp. 201 BOPD 25% wtr.

COMPLETED

County **Saline** State **Kansas**
 Sec. **1** (Blk.) **16** (Sur.) **4W** Map No.
 Operator **Phillips & Sanderson**
 Well No. **1** Farm **Ryding**
 Elev. Location **C S L SW NW**

FIRST REPORT

360 Ft. From **S** Line **NW**
660 Ft. From **W** Line Quarter
 1st. Report **AUG 15 1951**
 Completion
 Remarks
Melland Drlg. - Contr.
 Spudding Date **8-12-51**

Drlg. Data **Smolan Pool**
8" @ 350 WOC

240825

Map No. _____ Sec. 1 Twp. 16 R. 4W

Well No. 2 Ryding

Phillips & Sanderson Company

CORRECTION Contractor

SW SW SW

SECTION PLAT

_____ Ft. from N. Line

330 Ft. from S. Line

_____ Ft. from E. Line

330 Ft. from W. Line

Saline County

Location _____

Rig up _____

Drilling and Remarks:

Reported

#1 Ryding

C S L SW NW

RECORD

Cased _____ in., _____ ft.

Sand _____

Gas _____

Oil _____

Total Depth _____

PRODUCTION

1st 24 hrs. Nat. _____

1st 24 hrs. after shot _____

Gas _____ Cu. Ft.

Dry Hole _____

Abandoned _____

Date

AUG 22 1951 19

J. E. TYRA

Scout

County Saline State Kansas
 Sec. 1 (Blk.) 16 (Sur.) 4W Map No.
 Operator Phillips & Sanderson
 Well No. 2 Farm Ryding
 Elev. 1313 Location SW SW NW



330 Ft. From S Line NW
330 Ft. From W Line Quarter

1st. Report

Completion OCT 24 1951

Remarks Smolan Pool

Melland Drlg. - Contr.

Spudding Date 8-12-51

Drlg. Data Oil well TD 3423

8" @ 350 Miss. 2911 Kh. 3202

Maq. sh. 3358 Maq. dol. 3421-23

5" @ 3421 TD 3423 1 boph 750 A

S/ 5 boph Comp. 201 bopd 25% water

J. E. TYRA