


Section 1 Township 16 Range 4 W

Well No. # 3 Olsson

Company El Dorado Refg.

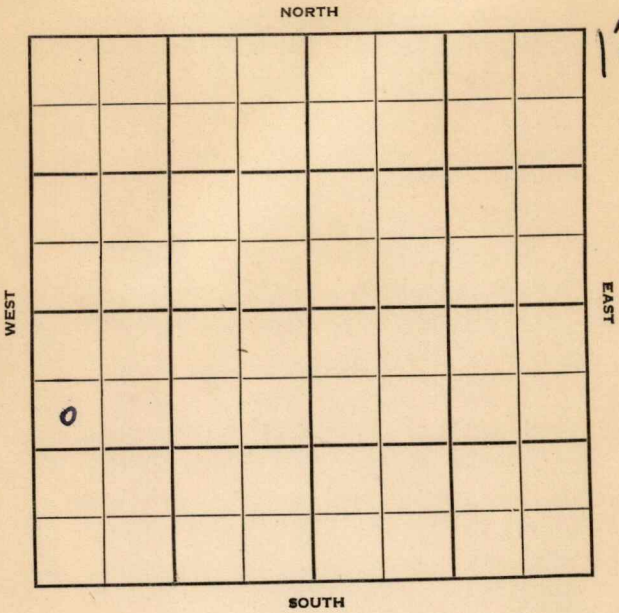

Saline

KANSAS

Sec. 1 Twp. 16 R. 4W

Well No. #3 Olsson Farm

El Dorado Refg. Company

Sterling - Contr. Contractor


990' Ft. from N. Line

_____ Ft. from S. Line

_____ Ft. from E. Line

330' Ft. from W. Line

SW NW SW

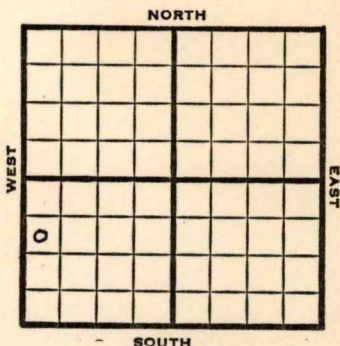

1952 **Elev. 1323'** REPORT

5/21 MIR
5/28 8" @ 371'
Drlg. 1955'
6/11 **Mq 3432-33' RTD** 5" @ 3432 CO 3433
2 1/2 BFPH 50% wtr. DD 3434 TD
S/2 1/2 BFPH for 4 hrs. 58% wtr.
6/18 NR
6/25 NR
7/2 NR
7/9 Spud 5-22-52
Oil well TD 3434' 8" @ 371'
Maq. 3432' 5" @ 3432' CO to 3433
2 1/2 BFPH 50% water DD 3434'
S/2 1/2 BFPH 58% water
Comp. 29 BOPD 80% water

COMPLETED

County Saline State Kansas

Sec. 1 (Blk. 16 (Sur. 4W Map No. 16)
(Twp.) (Rge.)

Operator Eldorado Ref.

Well No. 3 Farm Olsson

Elev. 1323 Location SW NW SW

990 Ft. From N Line SW
330 Ft. From W Line Quarter

1st. Report

Completion JUL 9 1952

Remarks

Sterling Drlg. - Contr.

Spudding Date 5-22-52

Drlg. Data Oil well TD 3434

8" @ 371 Maq. 3432 5" @ 3432

CO to 3433 2 1/2 bfph 50% water DD 3434

S/ 2 1/2 bfph 58% water

Comp. 29 bopd 80% water

J. G. McGENEE