



Sec. 1 Twp. 16 R. 4 W

Well No. # 3 Ryding Farm

Lee Phillips & Sanderson Company

Malland Contractor

Smolin


330 Ft. from N. Line

Ft. from S. Line

990 Ft. from E. Line

Ft. from W. Line

NW NE NW

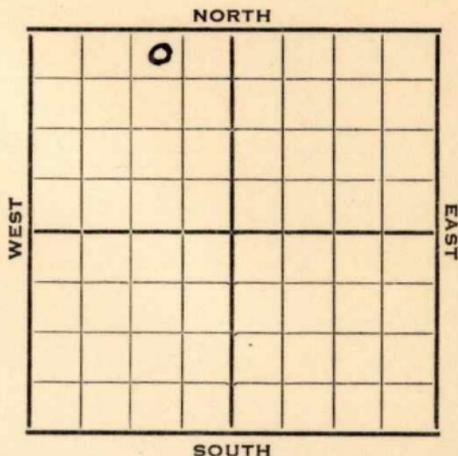

1952

**Elev. 1324'**

REPORT

2/27

Spud 2-21-52  
8" @ 360  
Drlg. 1456'

3/5

**Miss 2924'**  
**KH 3209'**  
**Mq. sha 3360'**  
**Mq. Dol 3433'**  
TD 3435'  
5" @ 3433' WOC

3/11

"

3/19

DP to 3435 S/9 BOPH POP

3/25

NR

4/1

"

4/9

"

4/23

NR

4/30

"

5/7

"

5/14

"

5/21

"

5/28

"

6/11

P/8 BOPH

6/18

NR

6/25

NR

7/2

Spud 2-21-52  
Oil Well TD 3435' 8" @ 360'  
**Miss. 2924** **Kh. 3209**  
**Maq. sh. 3360** **Maq. dol 3433**

OVER

1952

7/2 TD 3435' 5" @ 3433 DP to 3435  
S/ 9 boph P/ 8 boph  
Comp. 223 bopd

**COMPLETED**

County **Saline** State **Kansas**

Sec. **1** (Blk. **16** (Sur. **4W** Map No.

Operator **Lee Phillips & Sanderson**

Well No. **3** Farm **Ryding**

Elev. **1324** Location **NW NE NW**

	<b>a</b>				

**FIRST REPORT**

**330** Ft. From **N** Line **NW**

**990** Ft. From **E** Line **Quarter**

1st. Report **FEB 27 1952**

Completion

Remarks

**Malland - Contr.**

Spudding Date **2-21-52**

Drlg. Data **Smolin**

**8" @ 360 Drlg. 1456**

**J. G. McGEHEE**

