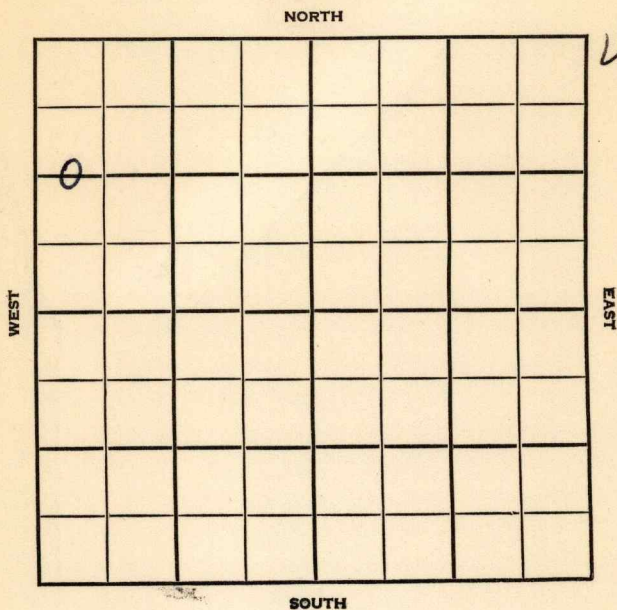


Section 1 Township 16 Range 4 WWell No. # 5 RydingCompany Phillips & Sanderson

Saline KANSAS

SEC.	TWP.	R.
1	16	1W

WELL NO. 5 Ryding FARM

COMPANY

CONTRACTOR Phillips & Sanderson


Melland
Smolan Pool

1320 Ft. from N. Line

Ft. from S. Line

Ft. from E. Line

330 Ft. from W. Line

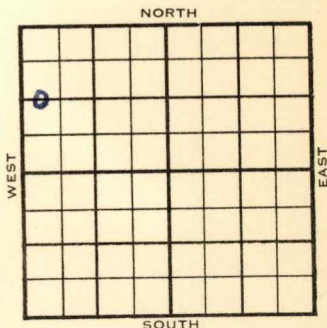

C W/2 W/2 NW

ELEVATION	REPORT
1955 1321'	

3/16 Spud 3-7-55
8" @ 363'
Drlg. 3164'

4/27 Spud 3-7-55
Oil Well
TD 3434'
8" @ 363'
Miss 2915', Kh. 3198' Maq. sh. 3365'
Maq. dol. 3432'
TD 3434'
5" @ 3432'
CO to 3434'
FU 300' oil 16 hr. frac. S/ 10 boph
Comp 25 bopd.

COMPLETED

Operator Phillips & Sanderson

Well No. 5 Farm Ryding

Elev.	Location	C	W $\frac{1}{2}$	W $\frac{1}{2}$	NW
60	SW corner				
70	SE corner				
80	NE corner				
90	NW corner				
100	center				

0

FIRST REPORT

1320 Ft. From N Line NW

330 Ft. From W Line Quarter

1st. Report MAR 16 1955

Completion

Remarks

Melland - Contr.

Spudding Date 3-7-55

Drig. Data Smolan Pool

8" @ 363 drlg. 3164

FABEN GILSTRAP

County Saline State Kansas
 Sec. 1 (Blk.
Twp.) 16 (Sur.
Rge.) 4W Map No.
 Operator Phillips & Sanderson
 Well No. 5 Farm Ryding
 Elev. 1321 Location C W $\frac{1}{2}$ W $\frac{1}{2}$ NW

1320 Ft. From N Line NW
330 Ft. From W Line Quarter

1st. Report

Completion APR 27 1955

Remarks Smolan Pool
Melland - Contr.

Spudding Date 3-7-55

Drlg. Data Oil well TD 3434

8" @ 363 Miss. 2915 Kh. 3198

Maq. sh. 3365 Maq. dol. 3432

TD 3434 5" @ 3432 CO to 3434

FU 300' oil 16 hr. frac S/ 10 boph

Comp. 25 bopd

FABEN GILSTRAP