


Section 34 Township 16 Range 13-W

Well No. 3 - Hogan

Company I.T.I.O.

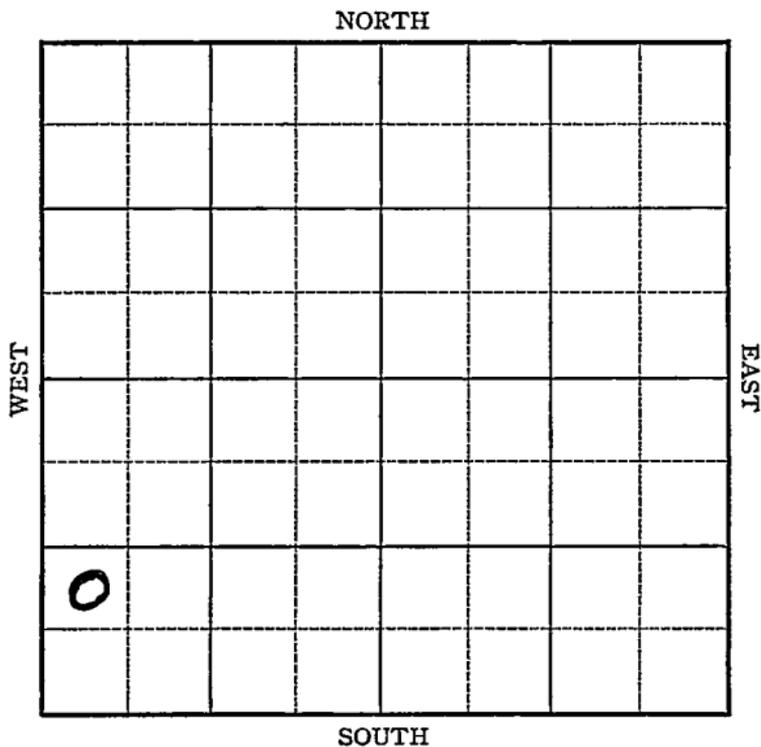



Barton KANSASMap No. \_\_\_\_\_ Sec. 34 Twp. 16 R. 13WWell No. 3-HoganI. F. O. Company\_\_\_\_\_  
Contractor

## FIRST REPORT

## SECTION PLAT

\_\_\_\_ Ft. from N. Line

990 Ft. from S. Line

\_\_\_\_ Ft. from E. Line

330 Ft. from W. Line


Location \_\_\_\_\_

Rig up \_\_\_\_\_

Drilling and Remarks:

B.R.R.

## RECORD

Cased \_\_\_\_\_ in., \_\_\_\_\_ ft.

Sand \_\_\_\_\_

Gas \_\_\_\_\_

Oil \_\_\_\_\_

Total Depth \_\_\_\_\_

## PRODUCTION

1st 24 hrs. Nat. \_\_\_\_\_

1st 24 hrs. after shot \_\_\_\_\_

Gas \_\_\_\_\_ Cu. Ft.

Dry Hole \_\_\_\_\_

Abandoned \_\_\_\_\_

Date

AUG 4 - 1937<sub>19</sub>H. D. Hatfield Scout

Map No. \_\_\_\_\_ Sec. 34 Twp. 16 R. 13W

Well No. 3-Hogan

I, T, I, O \_\_\_\_\_ Company \_\_\_\_\_

Contractor \_\_\_\_\_

**COMPLETED**

**SECTION PLAT**

0			

\_\_\_\_\_ Ft. from N. Line

990 Ft. from S. Line

\_\_\_\_\_ Ft. from E. Line

330 Ft. from W. Line

Location \_\_\_\_\_

Rig up \_\_\_\_\_

Drilling and Remarks:  
1000 acid

*potential*  
712 bbl

**RECORD**

Cased 7 in., 3395 ft.  
*Sections* Sand 3395

Gas \_\_\_\_\_

Oil \_\_\_\_\_

Total Depth 3406

**PRODUCTION**

1st 24 hrs. Nat. \_\_\_\_\_

1st 24 hrs. after shot \_\_\_\_\_

Gas \_\_\_\_\_ Cu. Ft.

Dry Hole \_\_\_\_\_

Abandoned \_\_\_\_\_

Date

SEP 8 1937 19

H. D. Hatfield

Scout