

Section 2 Township 16 Range 4 WWell No. # 1 Carlson-SandbergCompany Franko Central & Penguin Drlg.

NORTH

SOUTH

WEST

EAST

16

0

Sec. 2 Twp. 16 R. 4W

Well No. #1 Carlson-Sandberg Farm

Franke Central & Penguin Drlg. Company

Penguin Contractor

Smolin


 Ft. from N. Line

990 Ft. from S. Line

330 Ft. from E. Line

 Ft. from W. Line

NE SE SE

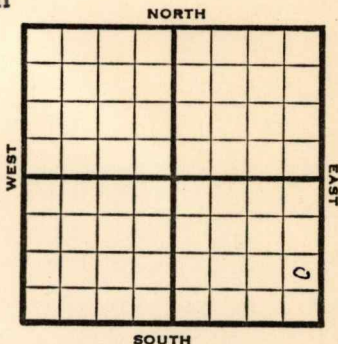

1952 Elev. 1332' REPORT

2/13 Spud 2-9-52
8" @ 2350'
Drlg. 890'

2/20 KC 2297 Drlg. 2940'

3/5 CO DD to 3446' TD
Fill up 350' oil while CO
S/39 BO 5½ hrs. POP

3/11 "

3/19 P est 96 BO & 5% wtr 17 hrs.

3/26 Spud 2-9-52
Oil Well TD 3446
8" @ 2350

KC 2297 Lans. 2298
Miss. 2931 Kh. 3227
Maw. 3378 Shale 3444-46
5" @ 3444 CO to 3446
FU 350' oil S/ 39 BO 5½ hr.
P. 96 BO 5% wtr. 17 hr.
Comp. 92 bopd 14% wtr.

COMPLETED

County **Saline** State **Kansas**
 Sec. **2** (Blk.) **16** (Sur.) **4W** Map No.

Operator **Franko Central & Penguin Drlg.**

Well No. **1** Farm **Carlson - Sandberg**

Elev. Location **NE SE SE**

FIRST REPORT

990 Ft. From **S** Line **SE**

330 Ft. From **E** Line Quarter

1st. Report **FEB 13 1952**

Completion

Remarks

Penguin - Contr.


Spudding Date **2-9-52**

Drlg. Data **Smolin**

8" @ 2350 Drlg. 890

J. G. McGEHEE

County Saline State Kansas
 Sec. 2 (Blk.) 16 (Sur.) 4W Map No.
 Operator Franco Central & Penguin Drlg.
 Well No. 1 Farm Carlson - Sandberg
 Elev. 1332 Location NE SE SE

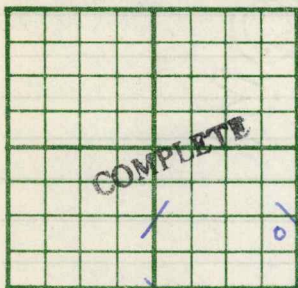

990 Ft. From S Line SE
330 Ft. From E Line Quarter

1st. Report

Completion MAR 26 1952

Remarks Smolan Pool
Penguin Drlg. - Contr.

Spudding Date 2-9-52

Drlg. Data Oil well TD 3446

8" @ 2350 KC 2297 Lans. 2298

Miss. 2931 Kh. 3227 Maq. 3378

Shale 3444-46 5" @ 3444 CO to 3446

FU 350' oil S/ 39 bo 5½ hr.

P/ 96 bo 5% water 17 hr.

Comp. 92 bopd 14% water

J. G. McGEHEE