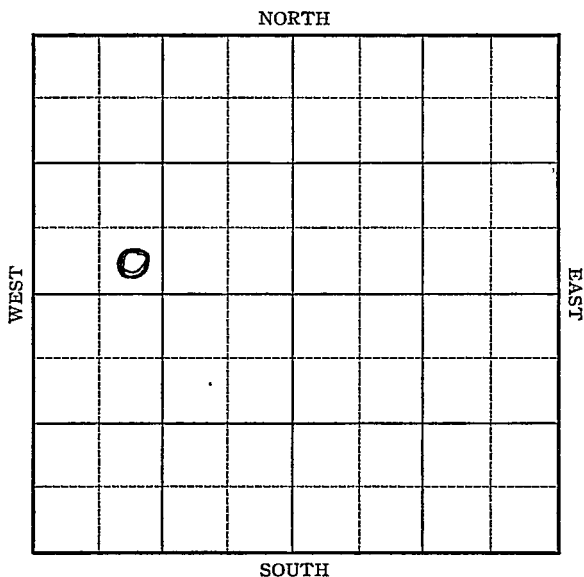


Barton

KANSAS

Section 34 Township 16 Range 13-WWell No. 5 - RiemanCompany Stanolind O&G

1937

10/20 6" @ 3517'.

Granite wash 3715'.

T.D. 3761'.

Salt water disposal well.

input--250 B.W. in 45 Min1

under 500# pressure.

ABANDONED

Barton KANSASMap No. _____ Sec. *34* Twp. *16* R. *13W*Well No. *5-Priman**Stanolind Oil & Gas* Company

Contractor _____

FIRST REPORT

SECTION PLAT

_____ Ft. from N. Line

330 Ft. from S. Line

_____ Ft. from E. Line

990 Ft. from W. Line

Location _____

Rig up _____

Drilling and Remarks:

BBR

RECORD

Cased _____ in., _____ ft.

Sand _____

Gas _____

Oil _____

Total Depth _____

PRODUCTION

1st 24 hrs. Nat. _____

1st 24 hrs. after shot _____

Gas _____ Cu. Ft.

Dry Hole _____

Abandoned _____

Date

SEP 1 1937 19 *H. D. Hatfield* Scout

Barton

KANSAS

Map No. _____ Sec. 34 Twp. 16 R. 13 WWell No. 5 RiemanStanolind

Company

Contractor

COMPLETED

SE SW NW

_____ Ft. from N. Line

330 Ft. from S. Line

_____ Ft. from E. Line

990 Ft. from W. Line

SECTION PLAT

0			

Location _____

Rig up _____

Drilling and Remarks:

*SALT water.**Disposal well**Input - 250 BW**IN 45 min. under**500 # pressure*

RECORD

Cased 6 in. 3517 ft.Sand Granite wash 3715

Gas _____

Oil _____

Total Depth 3761

PRODUCTION

1st 24 hrs. Nat. _____

1st 24 hrs. after shot _____

Gas _____ Cu. Ft.

Dry Hole _____

Abandoned _____

Date

OCT 20 1937H. D. Hatfield Scout