

Saline
16

KANSAS

Sec. 2 Twp. _____ R. 4W ✓

Well No. #1 Lockstrom Farm _____

Derby Oil Company _____

Carey Drlg. -Contr. Contractor _____


330' Ft. from N. Line

_____ Ft. from S. Line

330' Ft. from E. Line

_____ Ft. from W. Line

NE NE NE

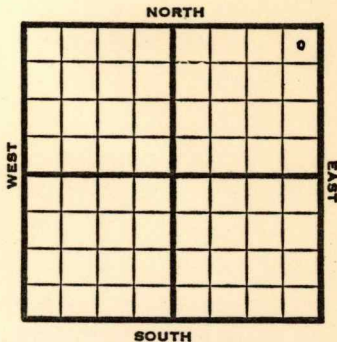

1951 **Elev. 1325'** REPORT

4/25 Location

6/5 Spud 4-24-51
 Oil Well TD 3442
 8" @ 339
 Miss 2914 Kinderhook 3198
 Maq. 3437
 DST 3438-42 opn 1/2 hr Rec. 1600' gas
 450' oil TD 3442
 4 1/2" @ 3438 S/12 boph P/18 boph
 500 A S/18 1/2 bo 2nd hr. 17 bo 3rd hr.
 Comp. EPI 1142 bopd

COMPLETED

County Saline State Kansas

Sec. 2 (Blk. 1 Twp.) 16 (Sur. Rge.) 4W Map No.

Operator Derby Oil

Well No. 1 Farm Lockstrom

Elev. 1325 Location NE NE NE

330 Ft. From N Line NE
330 Ft. From E Line Quarter

Ist. Report

Completion JUN 6 1951

Remarks

Carey Drlg. - Contr.

Spudding Date 4-24-51

COMPLETE

Drlg. Data Oil well TD 3442

8" @ 339 Miss. 2914 Kinderhook 3198

Maq. 3437 DST 3438-42 open $\frac{1}{2}$ hr.

Rec. 1600' gas 450' oil TD 3442

4 $\frac{1}{2}$ " @ 3438 S/ 12 boph P/ 18 boph

500 A S/ 18 $\frac{1}{2}$ bo 2nd hr. 17 bo 3 rd. hr.

Comp. EPI 1142 bopd