

Section 2 Township 16 Range 4WWell No. #2 CarlsonCompany El Dorado Refg.

		0					

NORTH

WEST

EAST

SOUTH

3

Saline

KANSAS



Sec. 2 Twp. 16 R. 4 W

Well No. # 2 Carlson Farm

El Dorado Refg.

Company

Sterling

Contractor

440

Ft. from N. Line


Ft. from S. Line

990

Ft. from E. Line

Ft. from W. Line

NW NE NW

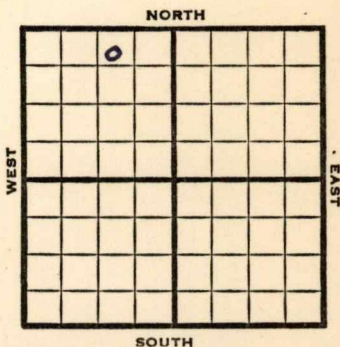

1952

Elev. 1330'

REPORT

8/6 Spud 8-3-52
8" @ 385
Drlg. 600'

8/13 Drlg. 2855'

8/20 **Mq Do1 3433'** RTD **3434'** 5" @ 3434'

8/27 CO 3435 900' oil 13 hrs. DD 3436
TD 1150' oil 17hrs.
S/6.65 BOPH POP


9/3 NR

9/10 NR

9/17 Spud 8-3-52
Oil Well TD 3436'
8" @ 385' **Maq. 3433** TD 3434
5" @ 3434 CO to 3435 FU 900' oil
13 hr. DD 3436 FU 1150' oil
17 hr. S/ 6.65 boph
Comp. 150 bopd 4% wtr.

COMPLETED

County Saline State Kansas
 Sec. 2 (Blk.) 16 (Sur.) 4W Map No.
 Operator E1 Dorado Refg.
 Well No. 2 Farm Carlson
 Elev. _____ Location NW NE NW

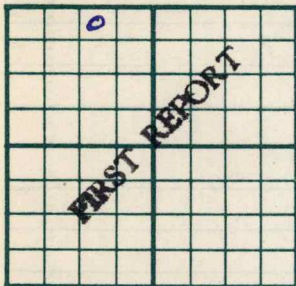

440 Ft. From N Line NW
990 Ft. From E Line Quarter

1st. Report AUG 6 1952

Completion _____

Remarks _____

Sterling - Contr.

Spudding Date 8-3-52

Drlg. Data _____

8" @ 385 Drlg. 600

J. G. McGEHEE

