


Section 1 Township 16 Range 4W

Well No. #4 Ryding

Company Phillips & Sanderson

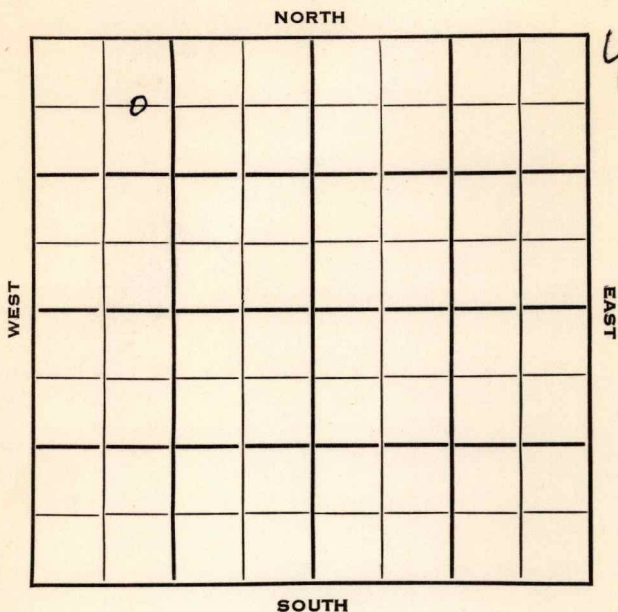

Saline KANSAS ✓

Sec. 1 Twp. 16 R. 4 WWell No. # 4 Ryding FarmPhillips & Sanderson Company

Contractor


660 Ft. from N. Line

Ft. from S. Line

Ft. from E. Line

990 Ft. from W. Line

C E L NW NW

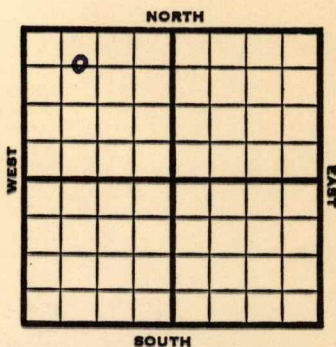

1953 Elev. 1325' REPORT

2/11 Location

2/19 8" @ 355
Drlg. 3602/26 Anhy 440
Drlg. 3155'3/12 Miss 2915' Kh 3209' Mq sha 3362'
Mq Dol 3432'RTD 3434' 5" @ 3432 DD 3436 TD
S/2½ BOPH 500 A

3/19 S/7½ BOPH

3/26 NR

4/2 NR

4/9 "

4/15 "pud 2-14-53

Oil Well

TD 3436

8" @ 355

Anhy 420, Miss 2915, Kh 3209, Maq
sh 3362, Maq dol 3432

TD 3434

5" @ 3432


DD 3436

S/2½ boph 500A S/7½ boph

Comp. 169 bopd 4% wtr.

COMPLETED

County Saline State Kansas
 Sec. 1 (Blk.) 16 (Sur.) 4W Map No. _____
 Operator Phillips & Sanderson
 Well No. 4 Farm Ryding
 Elev. _____ Location C EL NW NW

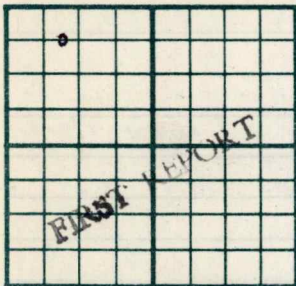

660 Ft. From N Line NW
990 Ft. From W Line Quarter

1st. Report FEB 11 1953

Completion _____

Remarks _____

Spudding Date _____

Drlg. Data _____

Location _____

County Saline State Kansas
 Sec. 1 (Blk.) 16 (Sur.) 4W Map No.
 (Twp.) (Rge.)
 Operator Phillips & Sanderson
 Well No. 4 Farm Ryding
 Elev. 1325 Location C E L NW NW

0					

660 Ft. From N Line NW

990 Ft. From W Line Quarter

1st. Report

Completion APR 15 1953

Remarks

Spudding Date 2-14-53

Drlg. Data Oil well TD 3436

8" @ 355 Anhy 420 Miss. 2915

Kh. 3209 Maq. sh. 3362 Maq. dol. 3432

TD 3434 5" @ 3432 DD 3436

S/ $2\frac{1}{2}$ boph 500 A S/ $7\frac{1}{2}$ boph

Comp. 169 bopd 4% wtr.

J. G. McGEHEE