
20-28-18E

STATE OF KANSAS
STATE CORPORATION COMMISSION

Give All Information Completely
Make Required Affidavit
Mail or Deliver Report to:
Conservation Division
State Corporation Commission
800 Bitting Building
Wichita, Kansas

WELL PLUGGING RECORD

NORTH

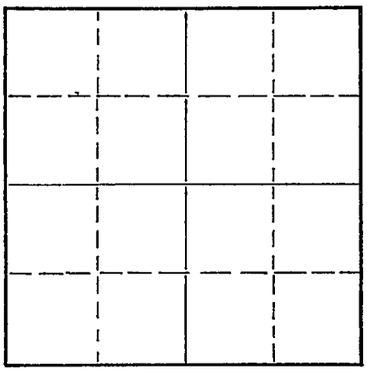

Locate well correctly on above Section Plat

Neosho County. Sec. 20 Twp. 28S Rge. 18E (E) (W)

Location as "NE/CNW¼SW¼" or footage from lines NE SE SE

Lease Owner Kenneth C. Keas

Lease Name Converse Well No. CT-3

Office Address Box 556, Chanute, Kansas 66720

Character of Well (completed as Oil, Gas or Dry Hole) oil

Date well completed 5-27-66 19

Application for plugging filed " 19

Application for plugging approved " 19

Plugging commenced " 19

Plugging completed " 19

Reason for abandonment of well or producing formation dry

If a producing well is abandoned, date of last production 19

Was permission obtained from the Conservation Division or its agents before plugging was commenced? yes

Name of Conservation Agent who supervised plugging of this well Vic Simoncic

Producing formation Depth to top Bottom Total Depth of Well 1074 Feet

Show depth and thickness of all water, oil and gas formations.

OIL, GAS OR WATER RECORDS — CASING RECORD

FORMATION	CONTENT	FROM	TO	SIZE	PUT IN	PULLED OUT
	Well record on back					

Describe in detail the manner in which the well was plugged, indicating where the mud fluid was placed and the method or methods used in introducing it into the hole. If cement or other plugs were used, state the character of same and depth placed, from feet to feet for each plug set.

Mud to 859 and spot fifteen sacks cement. Set bridge at 150' and put in five sacks cement. Set bridge at 25' and put in five sacks cement. Dirt to top.

(If additional description is necessary, use BACK of this sheet)

Name of Plugging Contractor K-K Drilling Company

Address Box 556, Chanute, Kansas 66720 License No. 573

STATE OF KANSAS, COUNTY OF NEOSHO, ss.

Kenneth C. Keas (employee of owner) ~~or (owner or operator)~~ of the above-described well, being first duly sworn on oath, says: That I have knowledge of the facts, statements, and matters herein contained and the log of the above-described well as filed and that the same are true and correct. So help me God.

(Signature)

Box 556, Chanute, Kansas 66720
(Address)

SUBSCRIBED AND SWORN TO before me this 31st day of May, 19 66

My commission expires 10-22-67

Janet Bloomer
Notary Public.

5441N

15	dirt and clay	15	
18	lime	33	
10	shale	43	
5	lime	48	
46	shale	94	
86	lime	180	
35	shale	215	
36	lime	251	
15	shale	266	
49	lime	315	
16	shale	331	
5	lime	336	
5	shale	341	
5	lime	346	
62	shale	408	
10	lime	418	
72	shale	490	
55	lime	545	
36	shale	581	
26	lime	607	
5	shale	612	
5	lime	617	
134	shale	751	
11	lime	762	
31	shale	793	
5	sandy shale	798	
10	sand	808	no oil
7	sand	815	bleeding some oil
3	shale	818	
22	sand	840	mica
2	shale	842	
4	sand	846	
23	lime	869	
31	shale	900	
5	lime	905	
21	shale	926	
129	lime	1055	top of Miss. 1048
19	sandy lime	1074	some dead oil in Miss. no odor