


Section 34 Township 16 Range 13-W

Well No. #4- Riemann

Company Stanolind

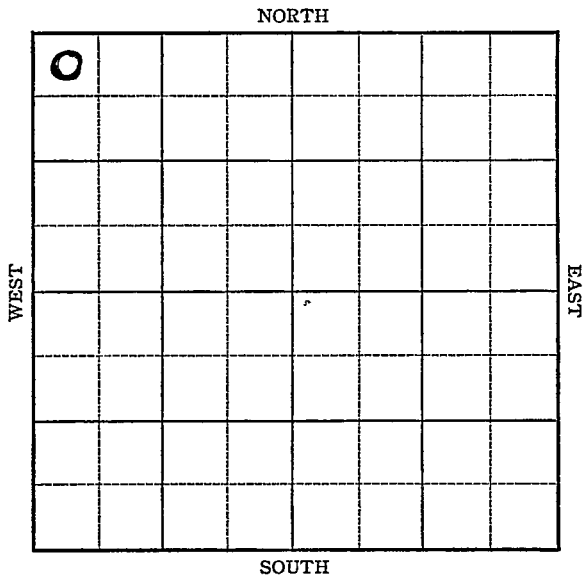

Sec. 34 Twp. 16 R. 13-W

Well No. #4 Riemann Farm

Stanolind Company


330 Ft. from N. Line

_____ Ft. from S. Line

_____ Ft. from E. Line

330 Ft. from W. Line

Elev. 1930

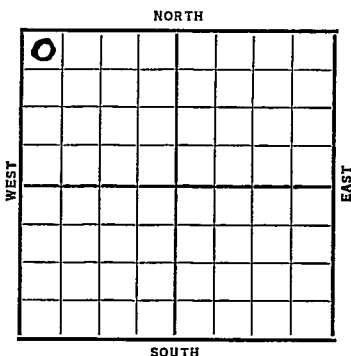

Date	REPORT
1937	
8/4	B.R.R.
8/13	T.D. 240' reaming.
8/20	12" @ 269'. Drlg. 2148'.
8/28	Sil. 3390'. T.D. 3395'.
	Rng. 7" ..
9/3	7" @ 3389'. Sat. 3390-95'.
	RUST.
9/10	"
9/15	7" @ 3389'
	Sil 3390'
	TD 3395'
	Pot 1944
	Nat.
	COMPLETED

Barton **KANSAS**Map No. _____ Sec. 34 Twp. 16 R. 13^WWell No. 4- RiemannStanolind Company

Contractor

FIRST REPORT**SECTION PLAT**530 Ft. from N. Line

_____ Ft. from S. Line

_____ Ft. from E. Line

330 Ft. from W. Line

①			

Location _____

Rig up 1

Drilling and Remarks:

*B.R.R.***RECORD**

Cased _____ in., _____ ft.

Sand _____

Gas _____

Oil _____

Total Depth _____

PRODUCTION

1st 24 hrs. Nat. _____

1st 24 hrs. after shot _____

Gas _____ Cu. Ft.

Dry Hole _____

Abandoned _____

Date

AUG 1 - 1937 19

H. D. Hatfield

Scout

Barto KANSAS

Map No. _____ Sec. 34 Twp. 16 R. 13^w

Well No. 4 - Riemann

Stanolind Company

Contractor

COMPLETED

SECTION PLAT

330 Ft. from N. Line

_____ Ft. from S. Line

_____ Ft. from E. Line

330 Ft. from W. Line

0			

Location _____

Rig up _____

Drilling and Remarks:

*pot - 1944
nat*

RECORD

Cased 7 in., 3389 ft.

Sand S11 3390

Gas _____

Oil _____

Total Depth 3395

PRODUCTION

1st 24 hrs. Nat. _____

1st 24 hrs. after shot _____

Gas _____ Cu. Ft.

Dry Hole _____

Abandoned _____

Date

SEP 15 1937 19

H. D. Hatfield Scout