


KANSAS

Saline

Section 29 Township 16 Range 1W

Well No. #3 Peterson

Company Deep Rock

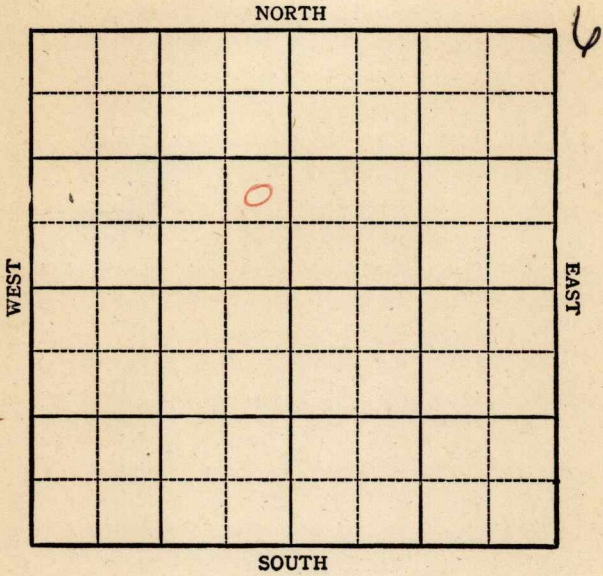

Sec. 29 Twp. 16 R. 1W

Well No. #3 Peterson Farm  
Deep Rock Company


Hunter

           Ft. from N. Line

990' Ft. from S. Line

330' Ft. from E. Line

           Ft. from W. Line

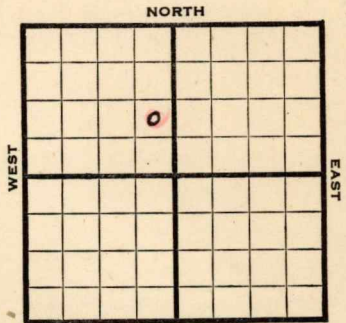

Elev. ~~1334~~ 1303

REPORT

1944

6/21

Rotary

6/28

10" @ 131  
Drlg 1735

7/12

Miss 2642-44 TD  
7" @ 2644 RUST

7/26

TD 2648 2½ fluid per hr 1/3 oil

8/2

TD 2669 swb 1-3/4 fluid per hr 50% wt

8/9

Drlg. 2775

8/16

Drlg. 2851

8/23

B Miss. 2843  
Drlg. 2955

8/30

Hunton 2946  
Drlg. 3034

9/8

3034 SD

9/13

" " "

9/20

Hunton 2946  
TD 3034  
SWD

**ABANDONED**



Pool Name Hunter Pool

Map No. 42 Sec. 29 Twp. 16 R. 1W

Well No. 3 Peterson

Deep Rock Company

**ABANDONED**

Contractor

NE SE NW

**SECTION PLAT**

         Ft. from N. Line

900 Ft. from S. Line

300 Ft. from E. Line

         Ft. from W. Line

	o		

Saline County

Location                                 

Rig up                                 

Drilling and Remarks:

*Hunter 2946*

*BWD*

**RECORD**

Cased          in.,          ft.

Sand                                 

Gas                                 

Oil                                 

Total Depth 3034

**PRODUCTION**

1st 24 hrs. Nat.                         

1st 24 hrs. after shot                         

Gas                          Cu. Ft.

Dry Hole                         

Abandoned                         

Date

SEP 20 1944

19

S. J. LEWIS Scout